CENTER SEC. 32-30-22
MONU. NO. 291
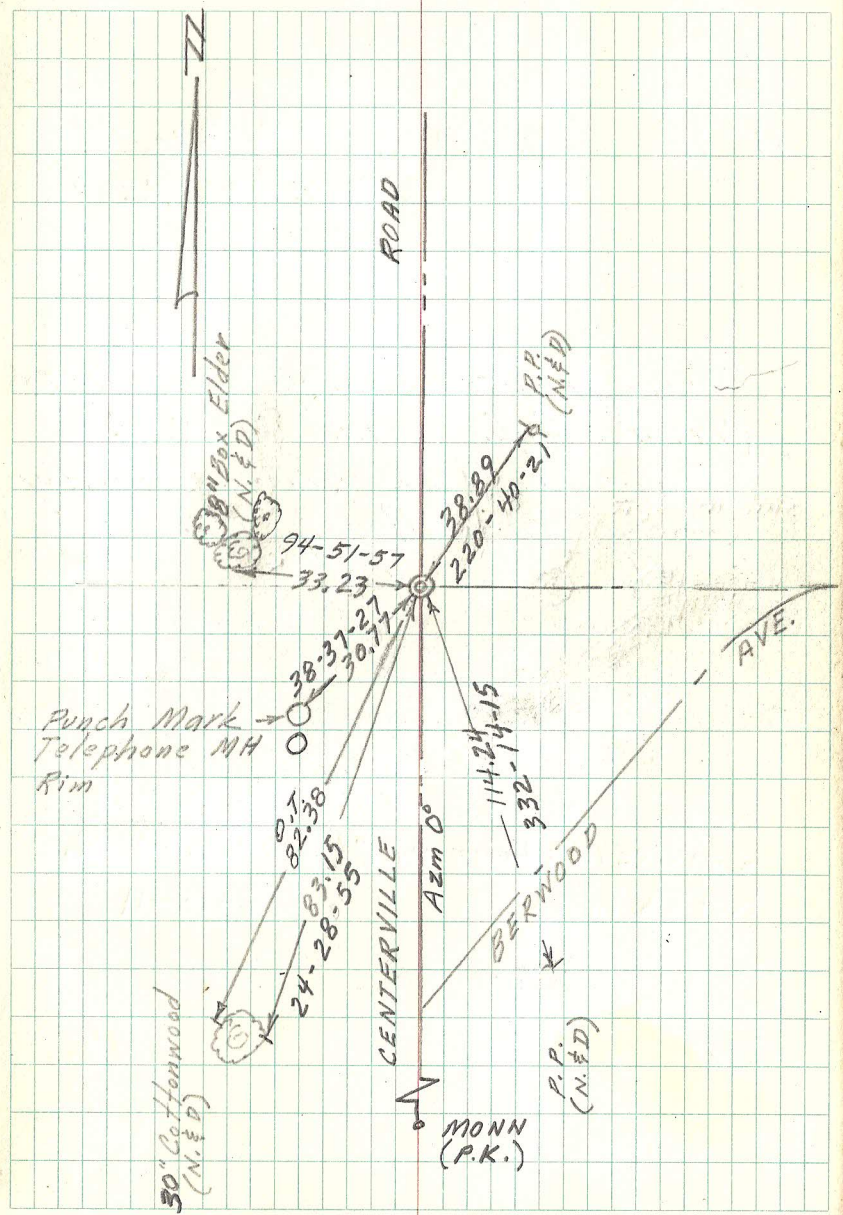
Found iron (down 0.4') 1½" dia.
in old concrete pavement.
Place Cast Iron cap and 3"
bolt in concrete flush with
surface. May 24, 1974.
Re-tied Aug. 13, 1975.
Re-tied Jan. , 1983
Cast iron cap gone. 1½" iron down
0.3± ft. Retied monu. 12-3-98
Re-tied AUG. 29, 2006
Retied monu. 9-7-11