NORTH 1/4 COR. SECTION 2, T29, R22
MONU. NO. 322
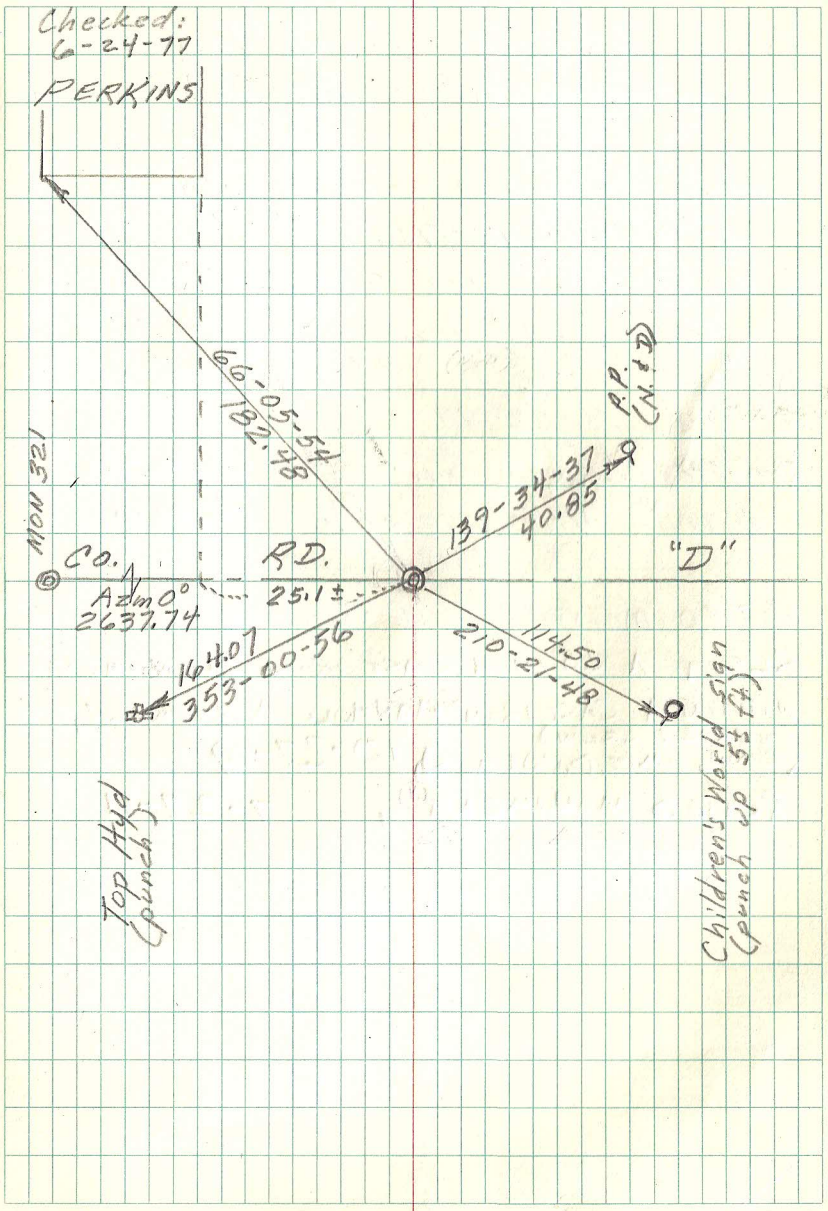
Found granite down 0.34 ft.; set cap. 1975
Retied mon. April 15, 1988.
Checked Aug. 8, 1990
Retied. 9-23-99
Tied monu. for MAPLE AVE. reconst. 4-29-02
Set 20" C.I. monu down 18"; set MH Cast. 8-16-02
RETIED MONT 6-22-06 (GG) SEE 323 ERASED
Retied Mont 11/4/11