CENTER SECTION 5, T 29, R 23
MONU. No. 327
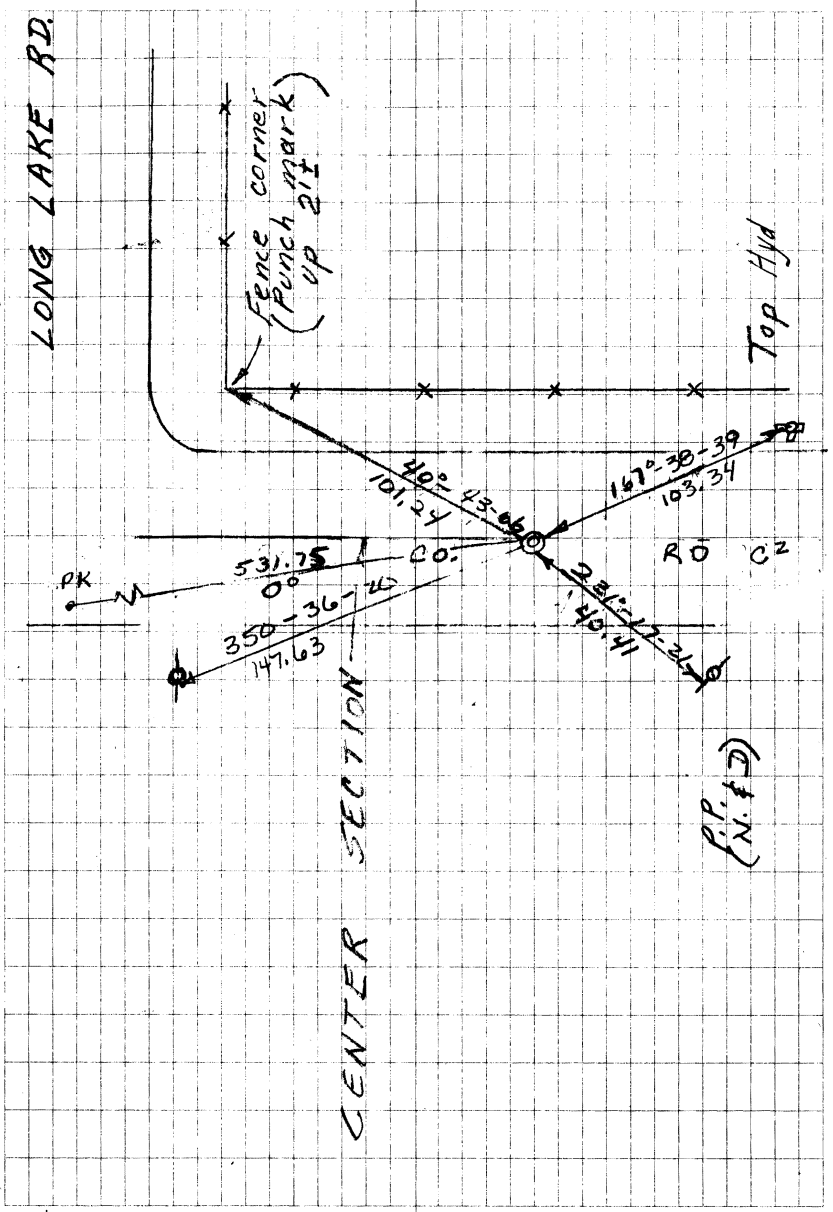
Found manhole at location; no ties left. 1975
Placed 20" cast iron monu. 33.00 ft. East on line to E¼ cor. Sec. 5.
Tied monu. 5-16-90
Monu. down 1½". 9-28-94
Tied Monu. JBL SB DV 7/16/02
Re-tied monu. 08-02-07