MONU. ON N. & S. 1/4 LINE
NEAR S. OWASSO BLVD.
SEC. 1, T29, R23
MONU. 335NN

Placed 20" cast iron monu.
on N. & S. 1/4 line S. of
S. Owasso Blvd in R.R. R/W.
10-18-91

Tied monu. (down 0.3 ft.) 4-23-92
(300.00' south of 335N on line
335N - 358).

Retied monu. (down 0.2') 8-8-02
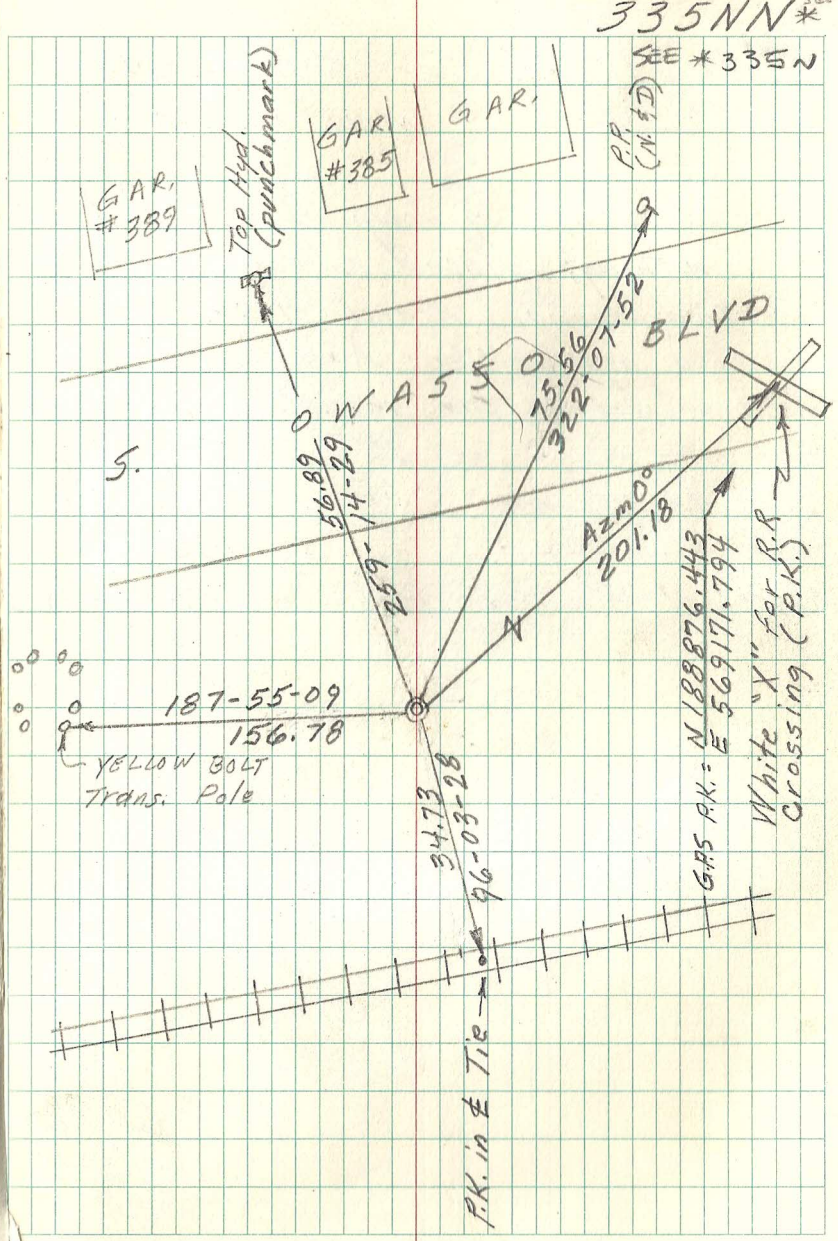
Retied monument, down +/- 0.8 ft.
SET SIGN & POST +/- 0.75 ft 7-21-09