

N.W. COR. SEC. 12-29-23

MONU. NO. 357

Found Cast Iron monu. broken
off and re-tied July 31, 1974.

Replaced with full cast iron. 12-2-74

Retied. Down o.i.t. 1-10-91.

Removed monu. for Maint. 6--00

Re-set monu. down 18", set MH
assembly. 9--00


Retied monu. 7-17-02

Retied monu. 08-03-07

Retied C.I.M. in C.I.M.H assembly 6-12-12

357
(MONU. NO. 357-N AFTER 359)

Checked:
7-14-77

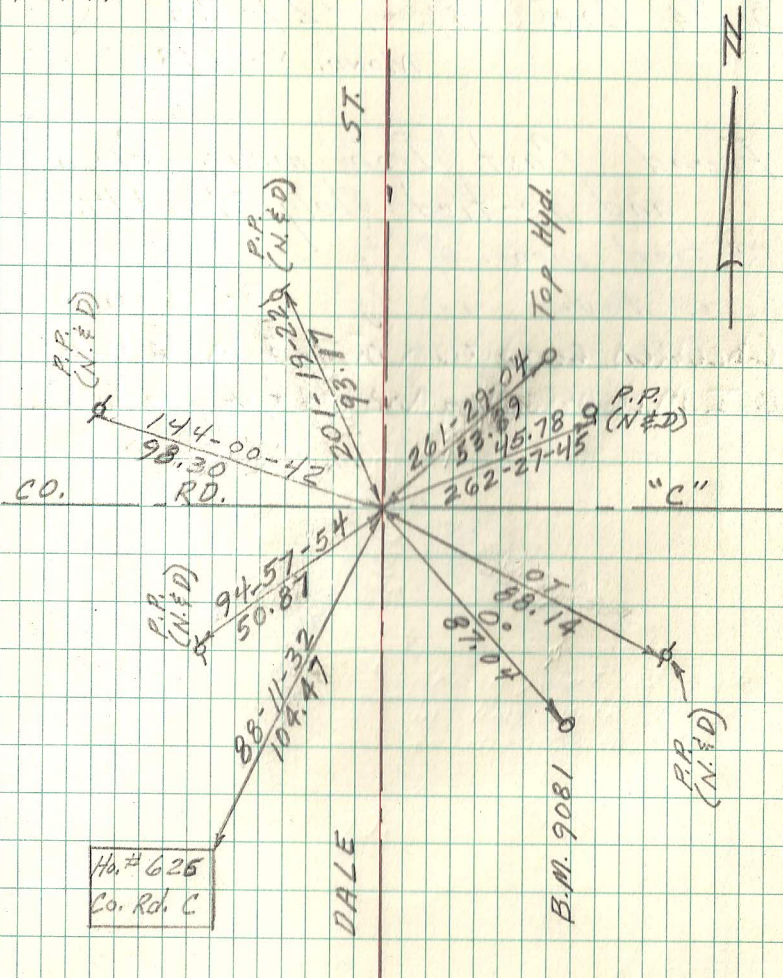

OT = old tie