Witness monu. to the S.W. cor of Section 5, T.29, R.22

Monu. No. 361N

The South West corner of Section 5 is in Savage lake (map shows a witness monument set in this location). 12-23-1896

Computed witness monument location based on map shown in Ramsey County Re-survey book. Excavated a 10ft x 10ft. area. Found 8in. x 8in. Granite Monument with a drill hole, down 3.5 ft in front yard of house no. 336, Offset monument. Front yard restored by others. 5-4-12

Set a "Ramsey County" 20 in. C.I.in. over granite monument using construction offsets; tied. Monument is flush in grass yard in front of house no. 336 7-27-12
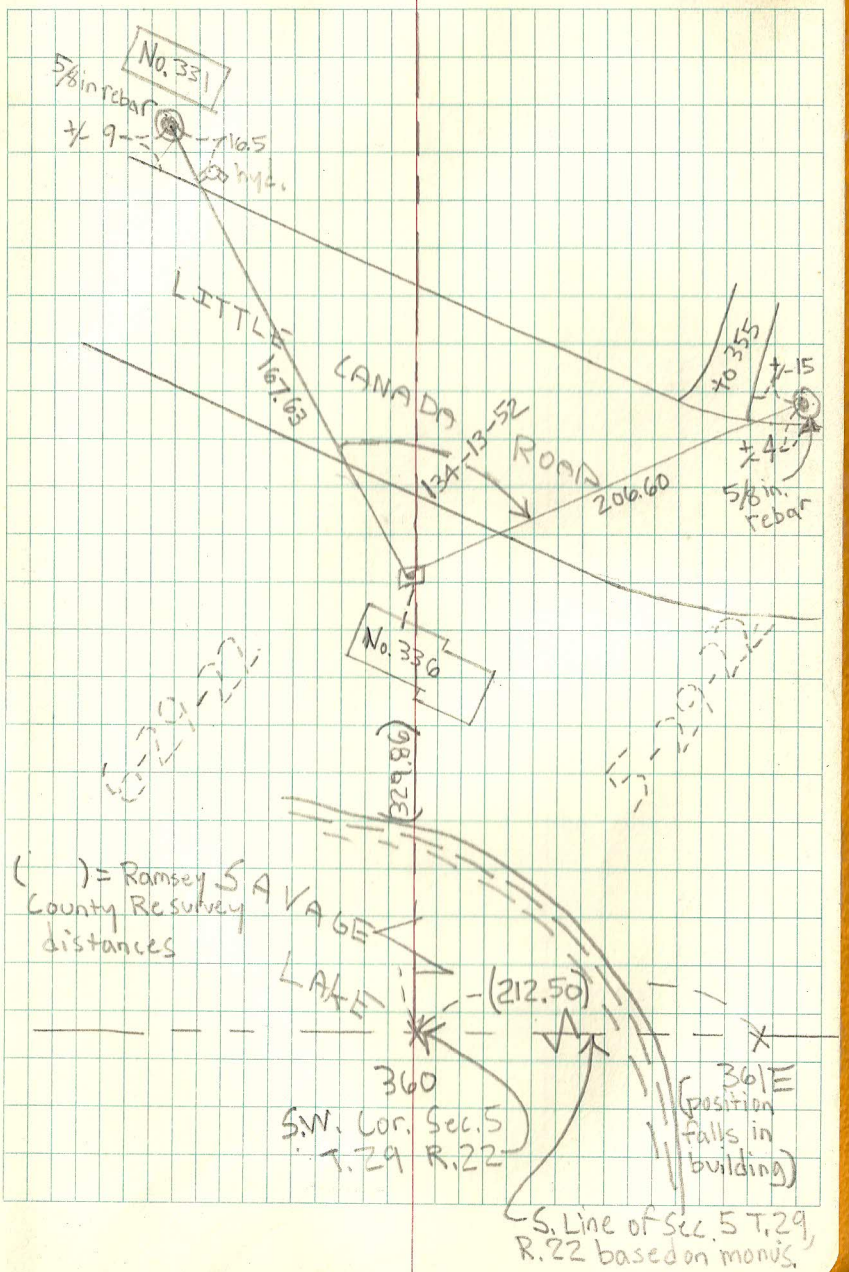
361N