

NORTH 1/4 COR. SEC. 9-29-22
Monu. No. 364

Found cast iron monument in place,
down 0.3 ft., 1974.

Tied monu. May 13, 1981.

Checked Aug. 8, 1990

Tied and removed 20" C.I. for Maint.

4-23-93


Replaced monu. (20" C.I.) 9-8-93

Retied. 12-09-99

RETIED MONU 6-28-06

Retied monu. 7-7-11

364

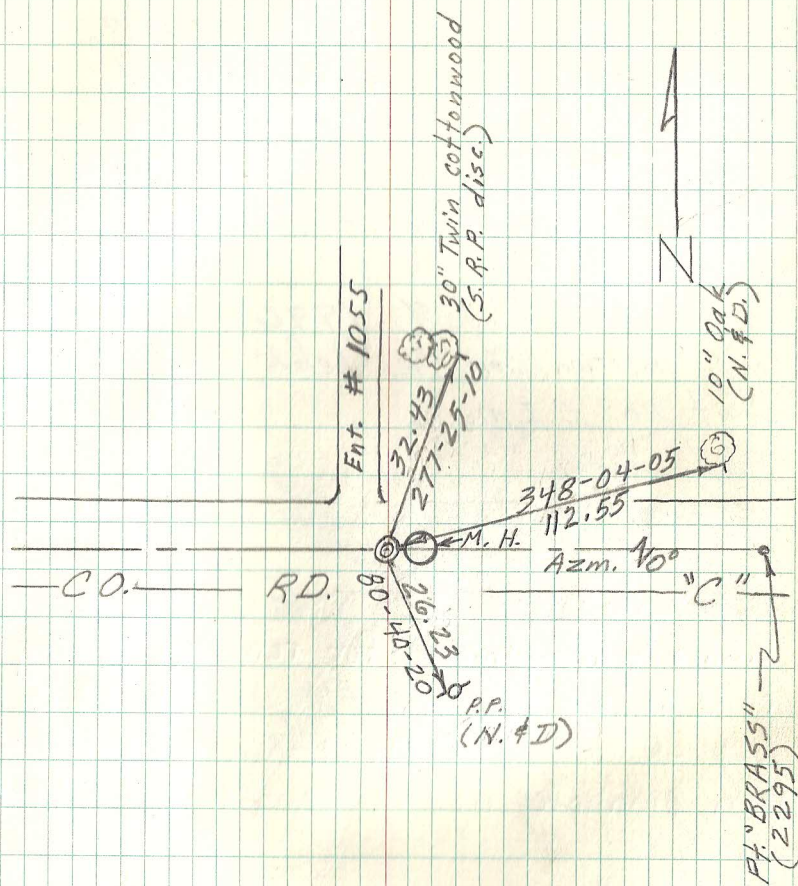

Checked: 9-12-77