


EAST 1/4 COR. SEC. 9, T29, R23  
MONU. NO. 376

Found cast iron monu. flush. 1974.  
Found Monu., top broken off, Aug. 13, 1990  
Removed old C.I.; placed 20"  
C.I. and retied. Aug. 14, 1990.  
RETIED MONUMENT, FLUSH 7-20-09

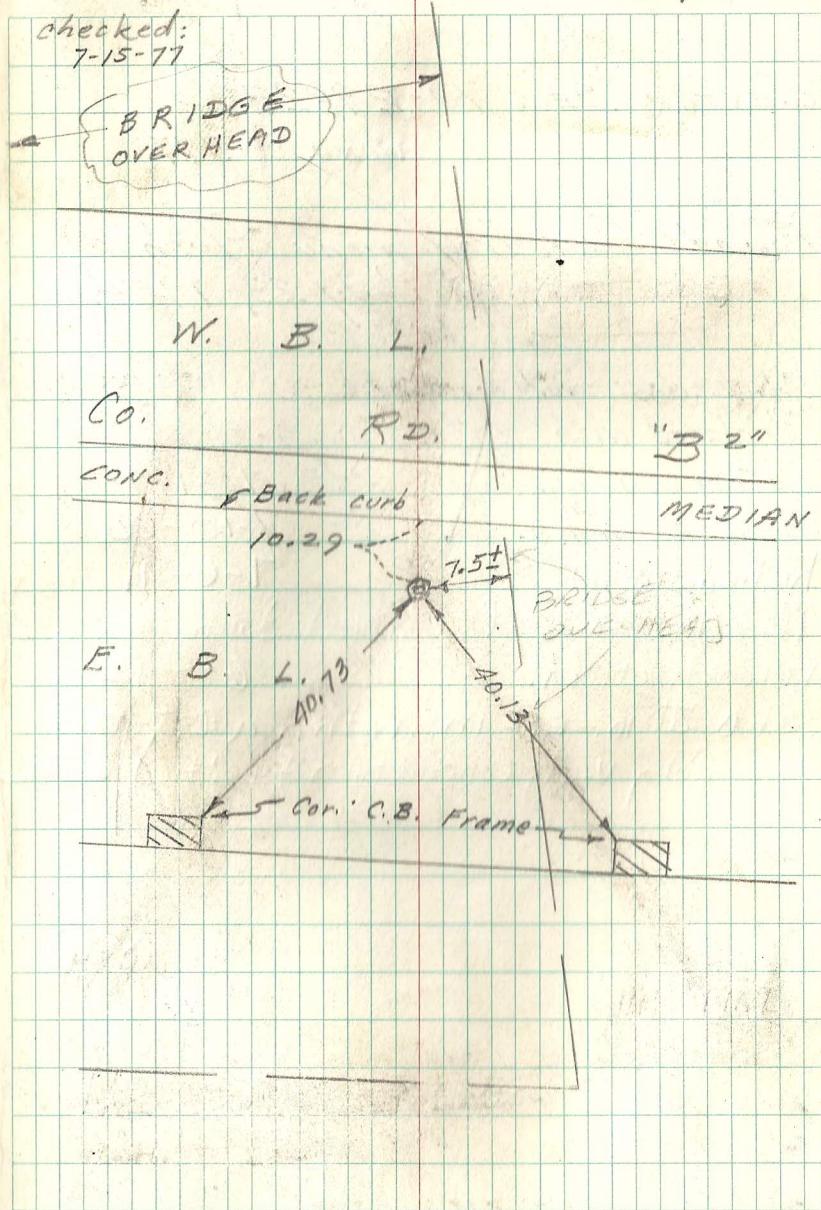

Comparing old road map for Snelling  
Ave and G.P.S. work, monu. appears  
to be in correct location. Angles  
and dist. compare good btwn NE  
and SE cor of Sec. 9. Feb. 3, 1988