CENTER SECTION 1, T30, R23
MONU. No. 37

Found Cast iron monu. down 0.3 ft.
Retied Jan. 23, 1976.
Raised cast iron after const..
May 27, 1976.
Replaced monu. after Sherwood
Ave. construction.
Retied monu. 7-16-90
Retied monu. 8-31-06 / 10-11-00
Monument removed for Full Depth
Milling operation then Replaced
With Manhole Casting Assembly
Placed around Castilon and retied (*) 9/18/05
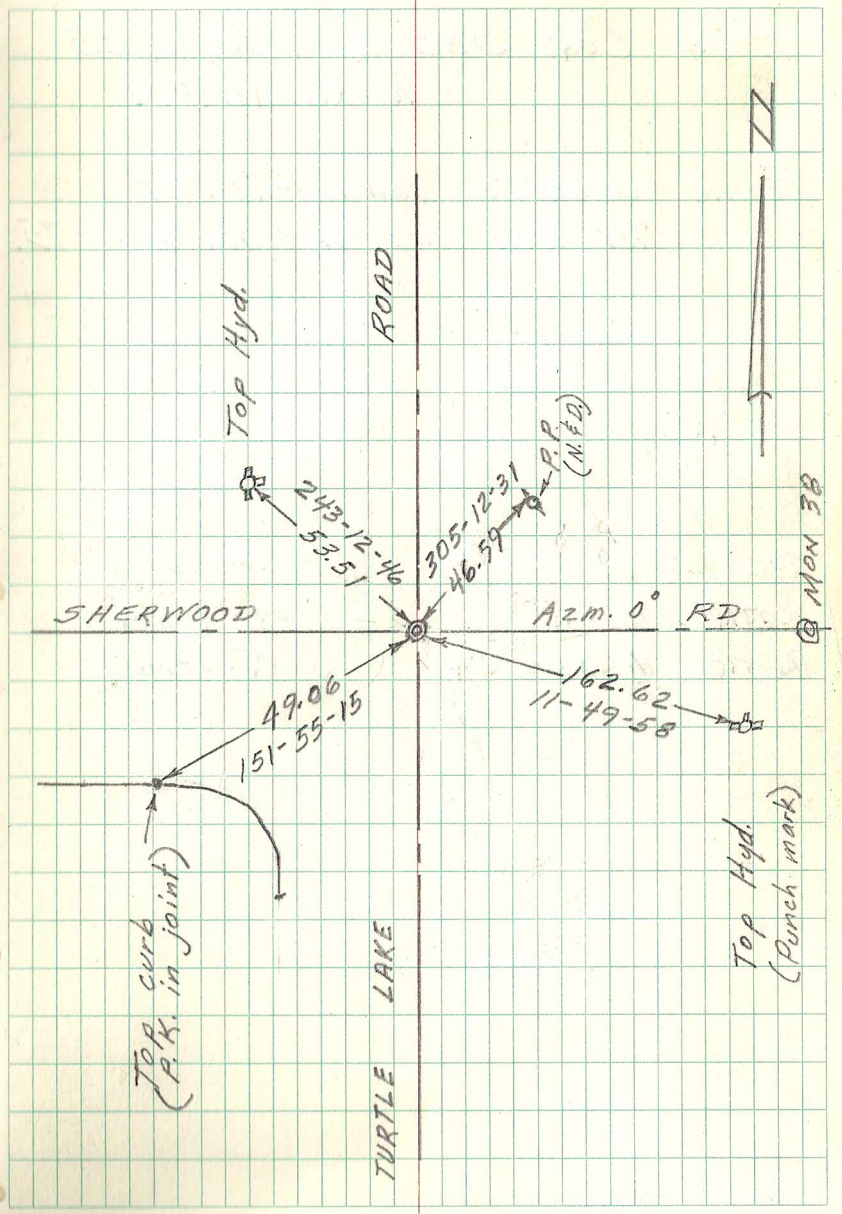
RETIED MONT. 6-09-04
RETIED MONT. 9-18-05*
RETIED MONUMENT 11-03-09