CENTER SECTION 10-29-22

MONU. NO. 389

Found M.H. at location. Put punch mark in top by using old ties from Maplewood City and Co. Hwy. Dept.. Placed cast iron witness monuments 33.00 ft. N. and E. on the quarter section lines.

Retied monu's. April 10, 1975.

Checked Aug. 9, 1990

Monu. destroyed by Maplewood.

Set 20" C.I.M. 10-13-92

Removed both C.I.M. for Maplewood. 6-13-97

Set 20" C.I's & MH castings at 389N & 389E at 16.5 ft N. & E. 5-13-98

Retied monu.. 4-2-01

RETIED MONUMENTS 8-08-06

Retied monuments 389N & 389E 6-30-11

Tied monuments 389N & 389E for removal during road reconstruction by City of Maplewood 6-26-13

M.H. assemblies for 389N & 389E removed and re-set by others. Cast iron monuments not disturbed by construction 11-6-13
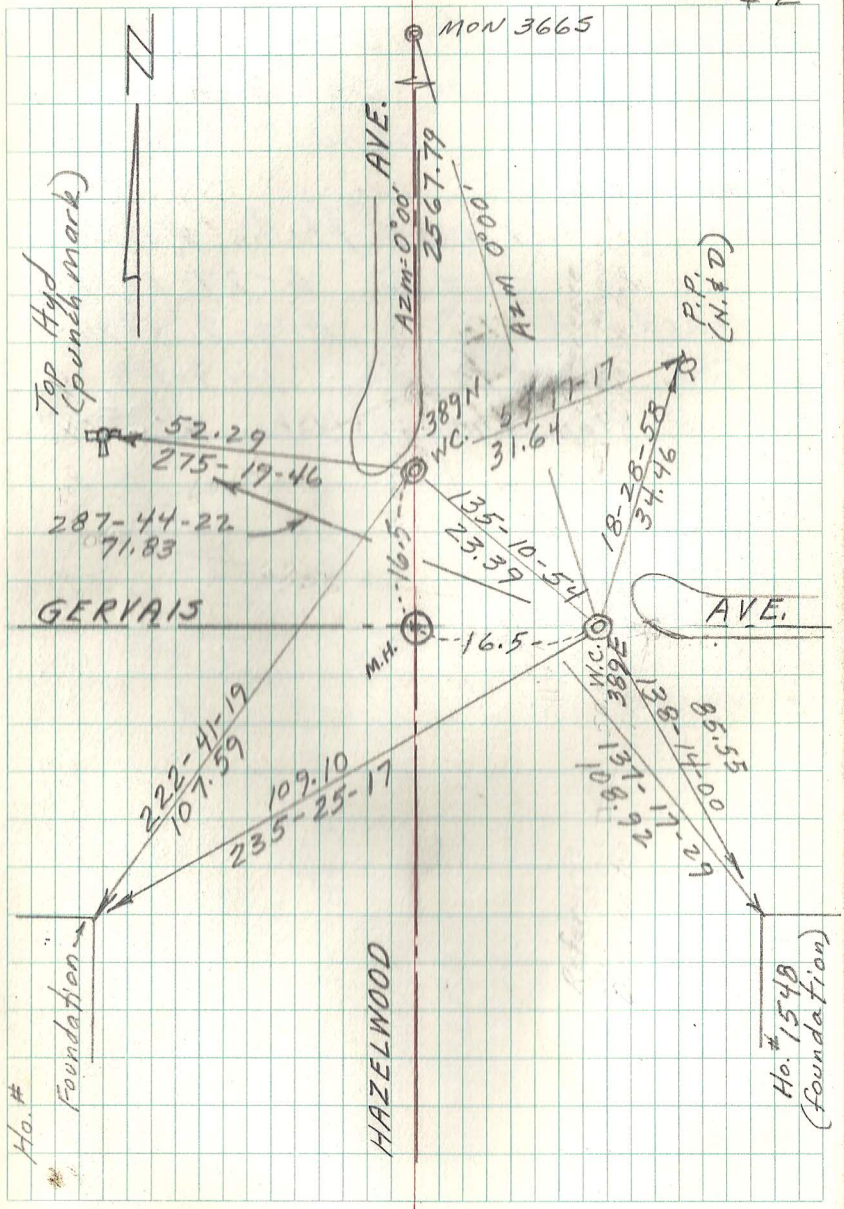
389 N & E