

SOUTH 1/4 COR. SEC. 9-29-23
MONU. NO. 398

Found cast iron monu. flush and
tied out. January 28, 1975

Retied monu. 8-13-90

Retied monu., 12-7-00

Mon. lowered for Milling/overlay

June 30, 2004.

Placed Manhole structure over

C.I. July 2004


TIED MONUMENT 7-15-04

RETIED. MONT. 8-24-06

Retied monu 6-20-11

398

checked:
7-29-77

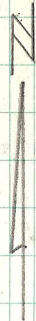

CO.

RD.

"B"

