438
N & E

EAST 1/4 COR. SEC. 14-29-22
MONU. NO. 438

Found MH at center street and broken off ref. mond. SWly.
Ref. monu. NEly & SEly missing. Sept. 16, 1974.

Found Cast iron witness corner 33 ft. north & placed a cast iron witness corner 33 ft. east of true position of 1/4 corner. Witness cor. are on line. Nov. 15, 1974.

Re placed E. witness corner after construction

Re-tied monu. July 12, 1984

Monuments Destroyed during McKnight Rd. Recon., 1988, placed P.K. for East Witness 1989, tied-out P.K. Aug. 3, 1990

Placed East monu. (20" C.I.) Aug. 16, 1990

North witness monu. (20" C.I.) set. 1993

Retied monu. 4-2-01

Lowered Monu. 438N to 12" below grade for Co. Maint. milling; set tube. 7-22-05

CONTINUED BTWN 439 & 440
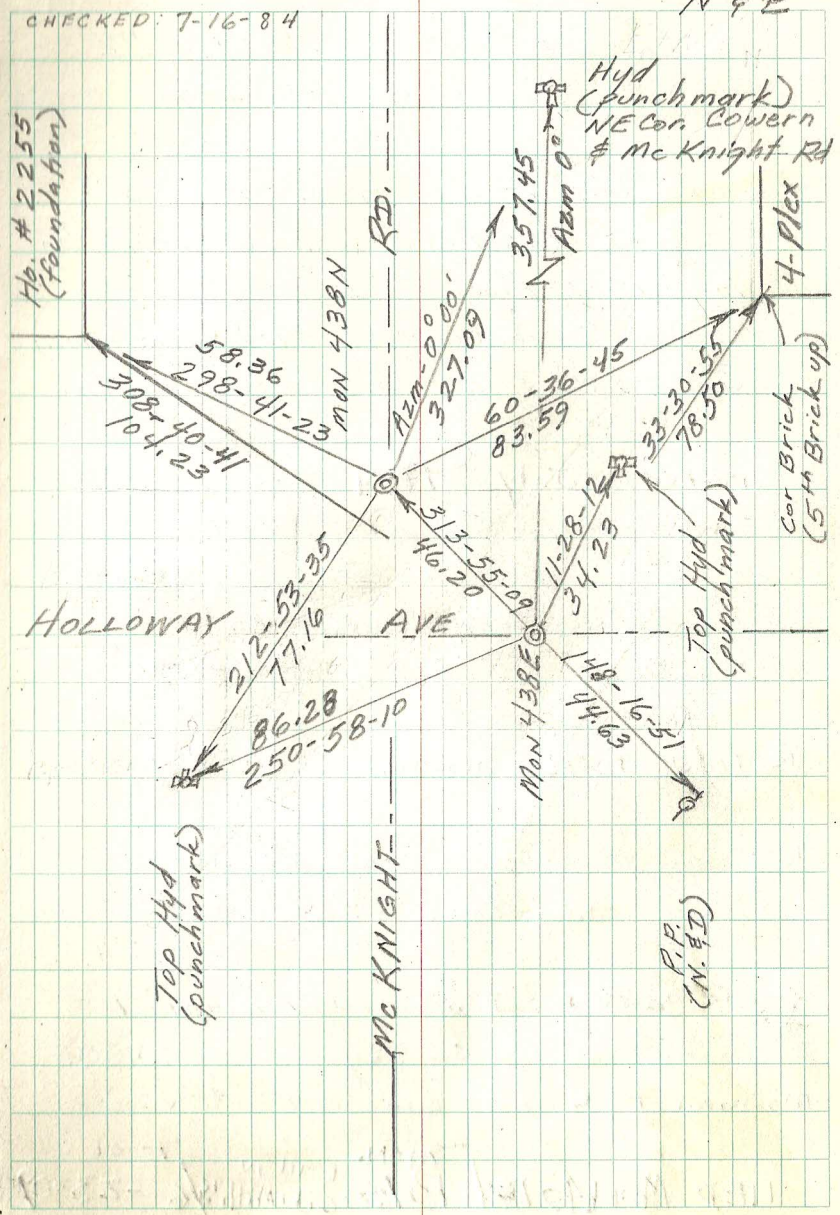
CHECKED: 7-16-84