N.E. Cor. Sec. 24, T29, R22
Monu. No. 463

Found granite down 4½". Placed bolt and cast iron cap 7-18-75.
Re-tied monu. Feb. 20, 1976.
Re-tied monu. down 0.38 ft. 9-24-93
Retied monu.. 4-15-03

Remove Bolt and Cast Iron Cap and Placed Cast Iron Manhole Assembly Around Granite (Down 0.9 ft.) June 28, 2005
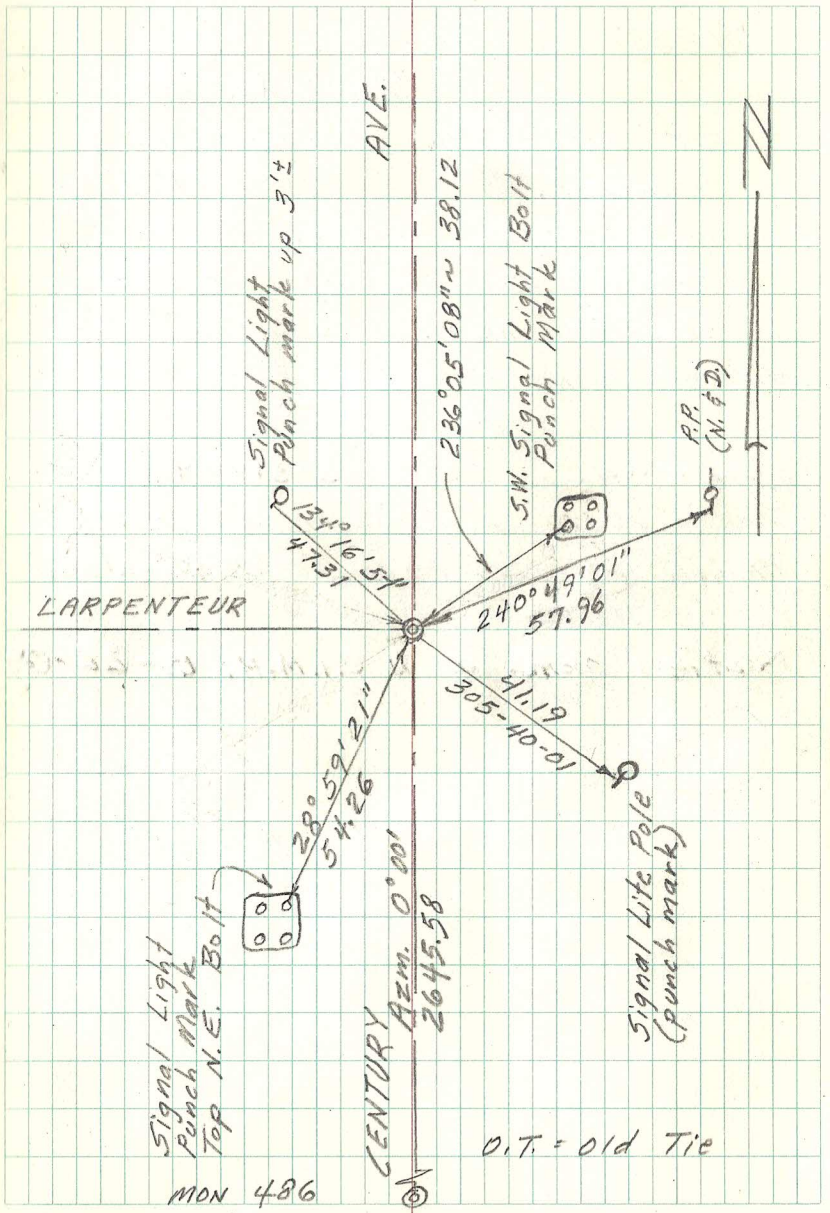
TIED GRANITE Monument, 10-24-08
Found granite monument, down 0.08 ft in C.I.M.H. assembly; checked condition of ties
A-25-13