NORTH 1/4 COR. SEC. 1-28-22
MONU. NO. 600
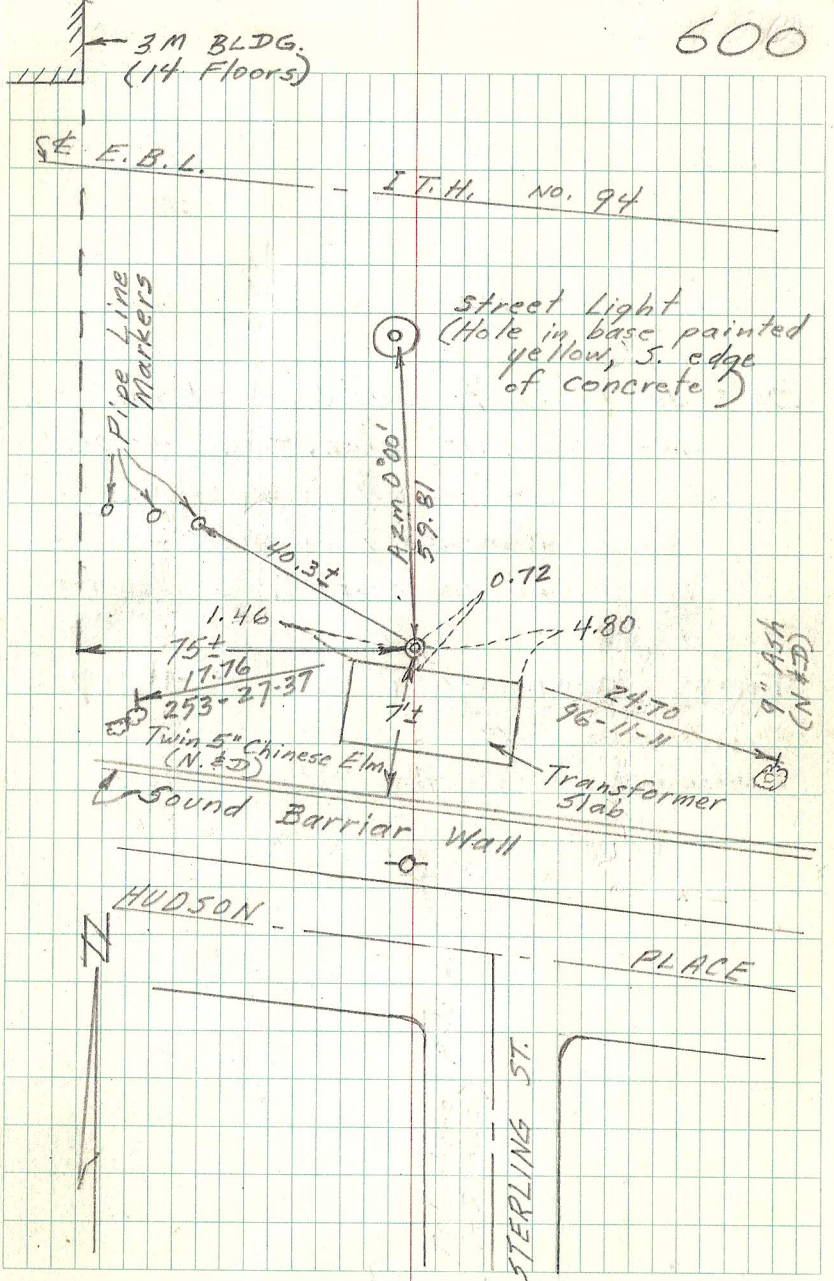
Found Cast Iron flush and re-tied Aug. 6, 1974
Monu. destroyed by MN DOT. Traversed and computed location. Checked tie to St. light (60.31m) and in place monu.. Had dug 7'± to find orig. C.I., no luck. June 20, 1989.
Placed 20" C.I. mon
Retied monu. 4-18-90.
Retied monu. 4-10-01
MONUMENT GONE 8-21-06