N 1/4 Cor. Sec. 11-30-23

Monu. No. 60
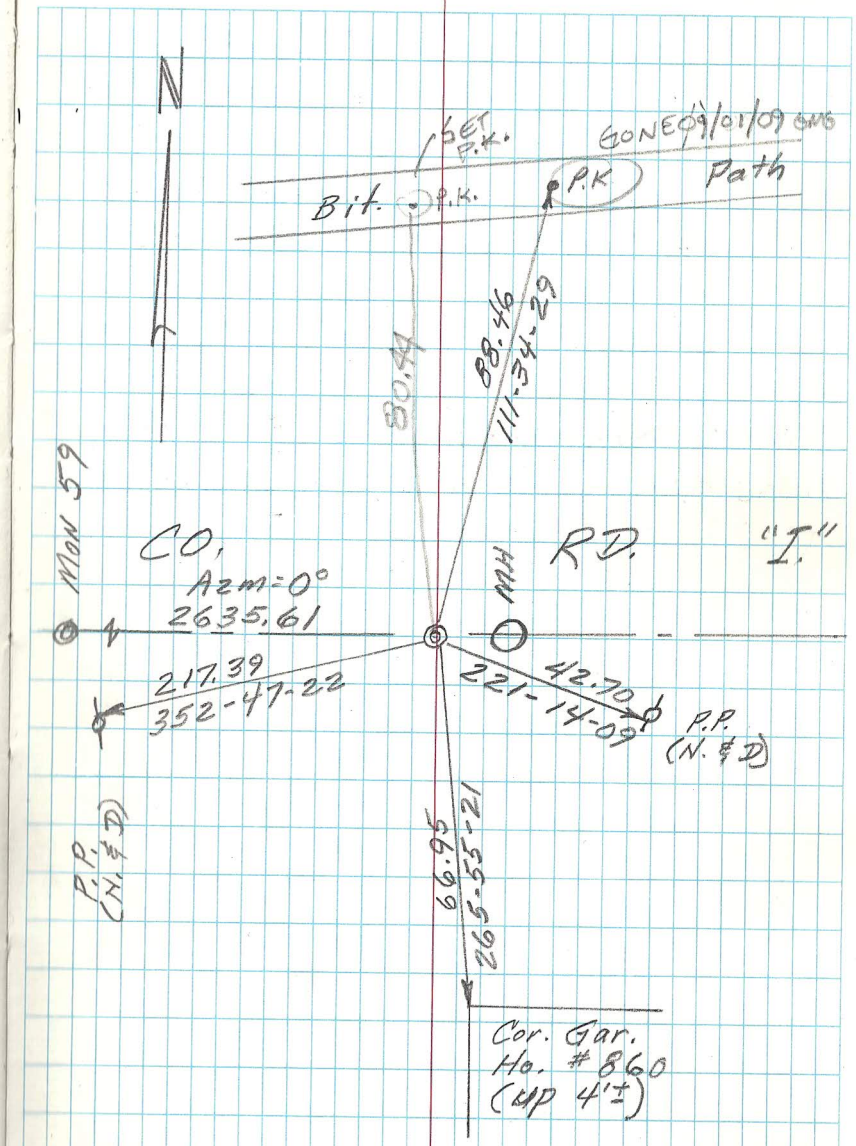
Found Cast Iron monu. Flush with road. Re-tied 6-21-74
Reset 20" C.I. flush. 10- -96
Retied monu. 3-21-01
RETIED MONT. 8-27-04
CEMENTED AROUND MONT. 8-25-06
RETIED MONUMENT 9-01-09