


669-E

SIXTEENTH COR. BTWN. CENTER SEC.
& EAST 1/4 COR. SEC. 12-28-22
MONU. NO. 669-E

Found field stone down 0.1 ft.
under barb wire fence with
iron on East side. Field
stone has "X" marked on
top. Dec. 18, 1974.

TIED MONUMENT. 6-10-09

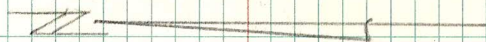

E 1/4 Cor. Sec. 12-28-22
Cast Iron (moved
4-12-76)



Center Sec. 12
granite