

S. E. COR. SEC 1, T30, R22
MONU. NO. 75


Found granite monu. flush;
retied. 1976

Retied monu. 12-7-99

RETIED MONT. 10-27-04

RETIED MONUMENT 11-18-09

For 75-N Look in back of book.

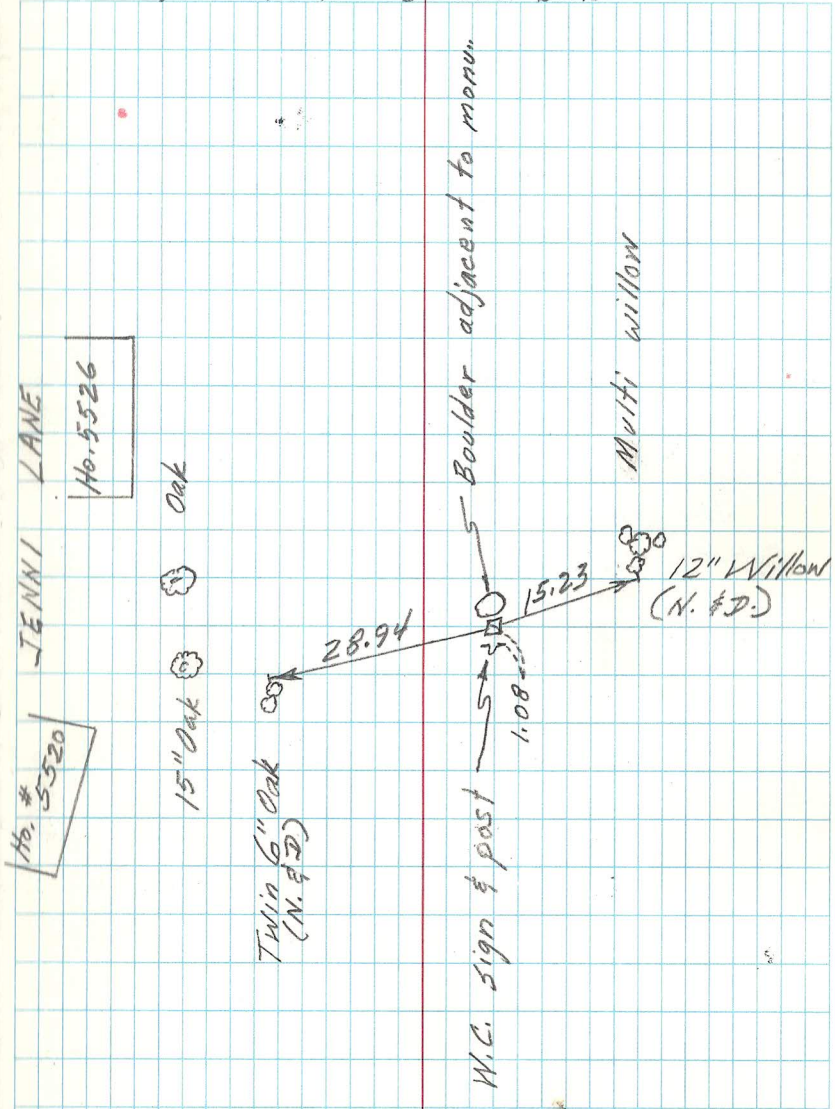

checked: 1-11-83