EAST 1/4 COR. SEC. 9-30-23
MONU. NO. 82
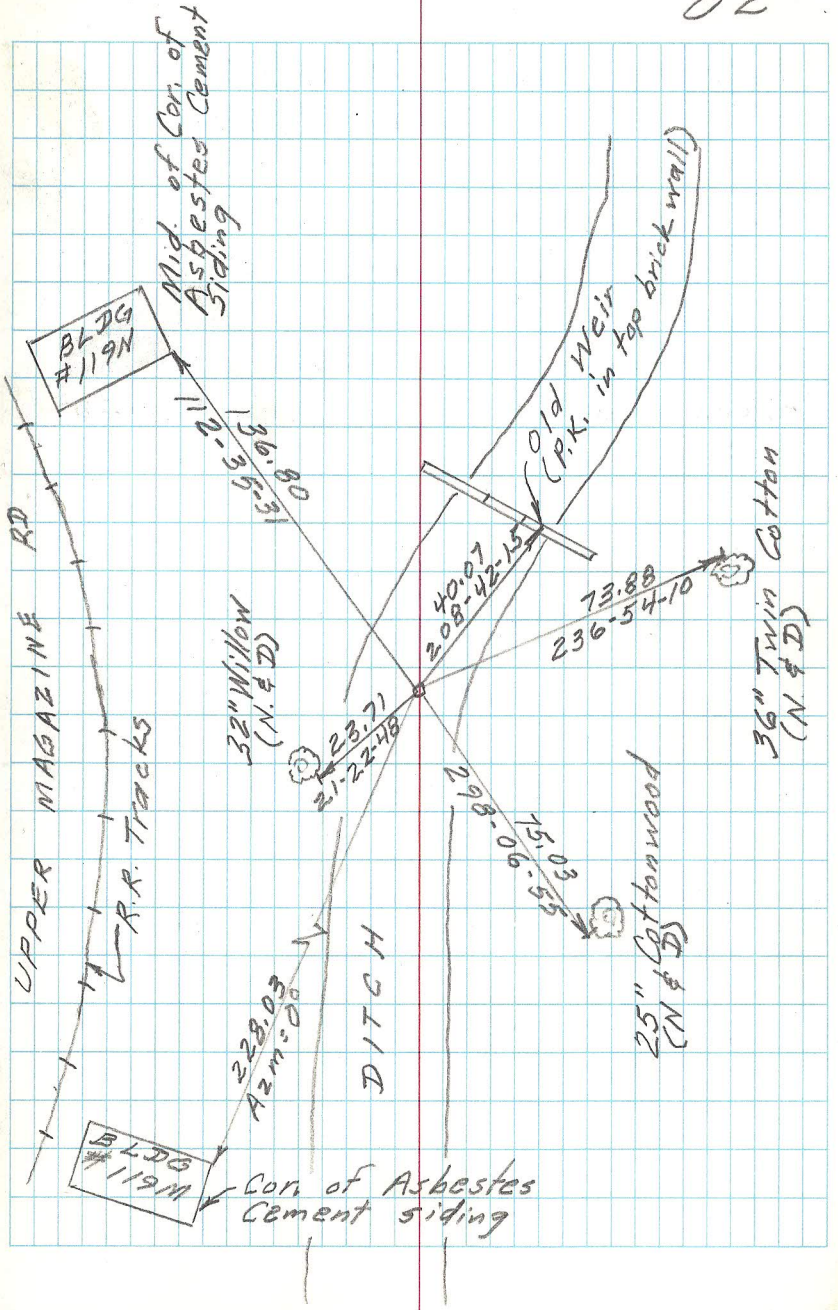
Found 4" open iron pipe up 3'± in conc. base in ditch. Monu. set by in July 1961.
Tied pipe out. Aug 8, 1991
Placed sign & post 2'± east. 8-26-91
Retied monu. (4" pipe up 3'± leaning S/y.). 4-06-01
RETIED MONT 3-09-05
Retied monu. 11-3-10