WEST 1/4 COR. SEC. 11-30-23
MONU. NO. 84

Found granite down 0.43 ft. Set short (4 3/8") cast iron. 7-16-75
Retied 7-28-75
Removed short cast iron for Const. Dept.. Granite destroyed. 4-30-90
Set 20" cast iron monu.. 8-21-91
Tied monu. & cemented top. 8-29-91
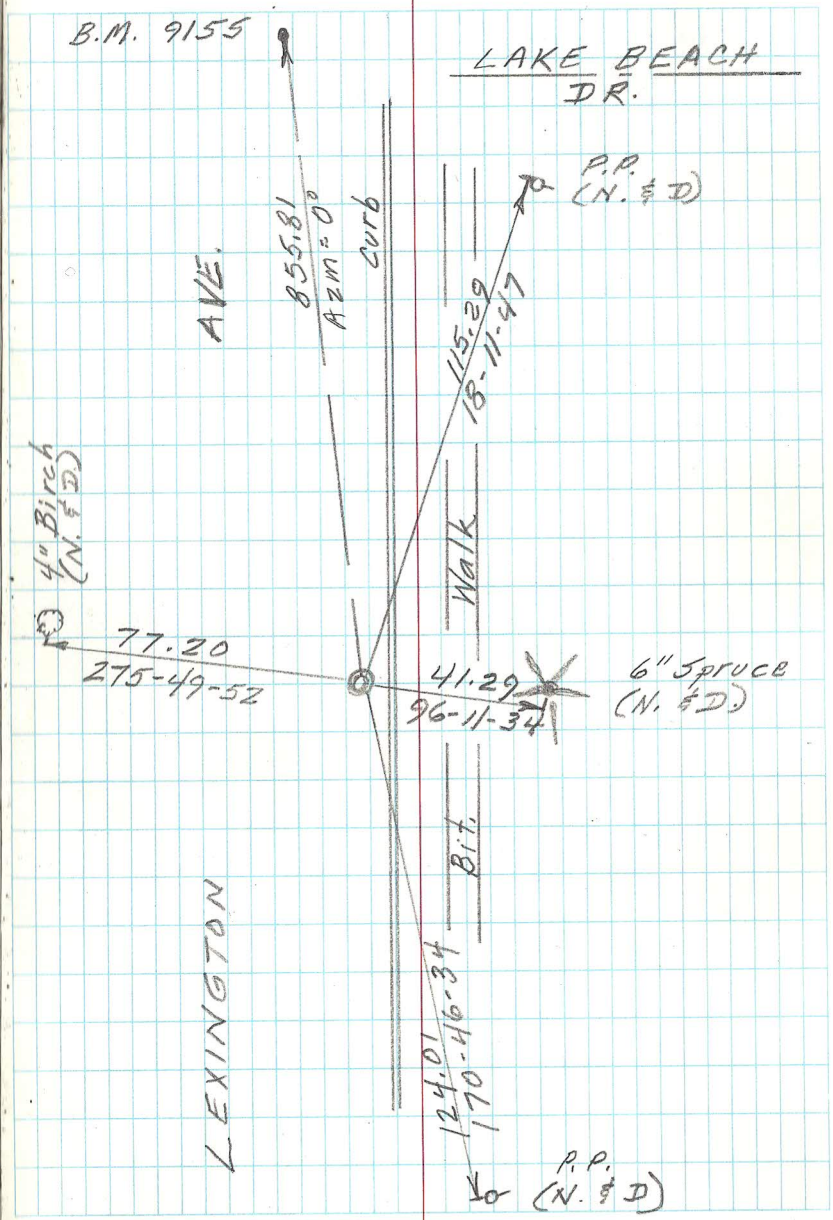
Removed & lowered C.I., set 12" tube for monu.. 4-30-02
Set 12" MH assembly. 5-14-02
Retied monu.. 11-22-02
Retied monu. 06-28-07