CENTER SEC. 10, T30, R22

MONU. NO. 95

Found granite monu. down 0.6 ft.. Placed Cast iron cap and bolt in conc. over it. May 21, 1974.

Retied. July 3, 1974

Removed cap for milling proj. 1989. After milling, granite is down 0.95 ft.t.. Placed 0.8'± custom welded C.I. monu.. 9-25-89

Retied monu.. 1-26-93

Retied " " 4-14-99

RETIED 11-15-04

RETIED MONUMENT 10-13-09
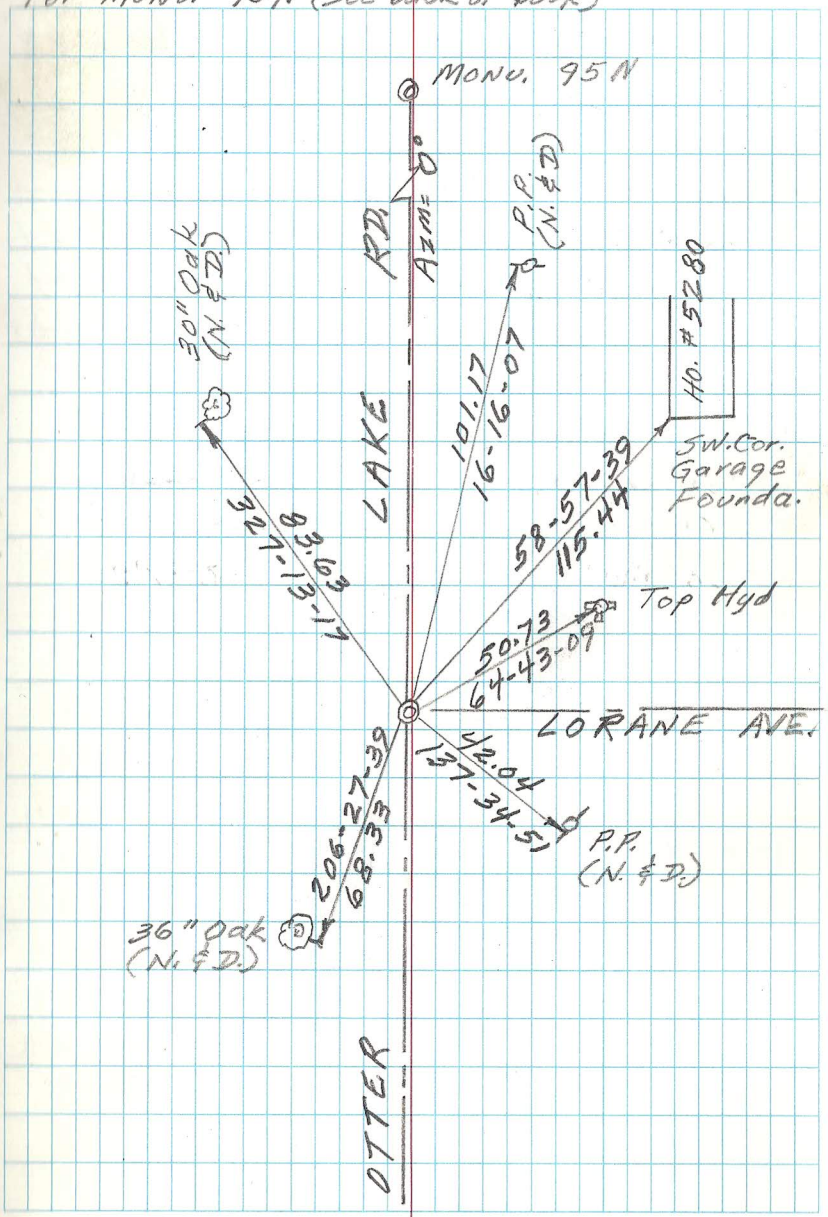
For MONU. 95N (See back of book)