EAST 1/4 COR. SEC. 11-30-22

MONU. NO. 98

Found granite up 0.3 ft.. 5-17-74.
Retied monu.. Oct 21, 1974
Retied monu. Dec. 4, 1992
Retied, set sign & post. Dec. 7, 1999
RETIED, 10-25-04
Retied monu. 8-4-10
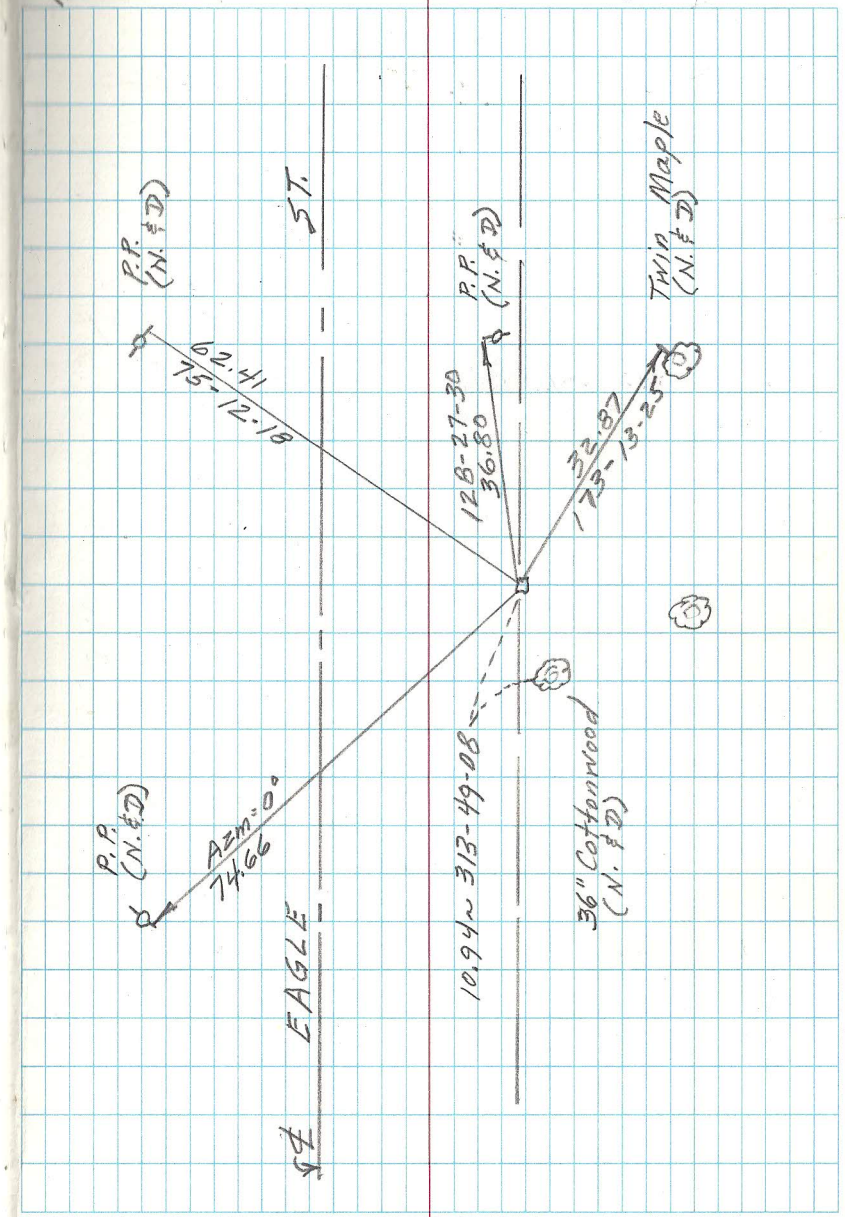
(FOR MON. 97E look btwn 79 & 80)