

NW 1/4, SECTION 13, TWP. 29, RGE. 23


$91.32'$   
 $89.58$  70  
 $179.90$  30     3' 30" Difference

PP  
 O  
 Disk 53.03  
 104  
 Manacle  
 38.22  
 52.59  
 PP  
 PK Nail

A 7.99  
 28.11

2611.4 R

Cor  
 F.  
 100.80  
 R  
 2613.40  
 2613.42  
 M  
 54.48  
 OPP

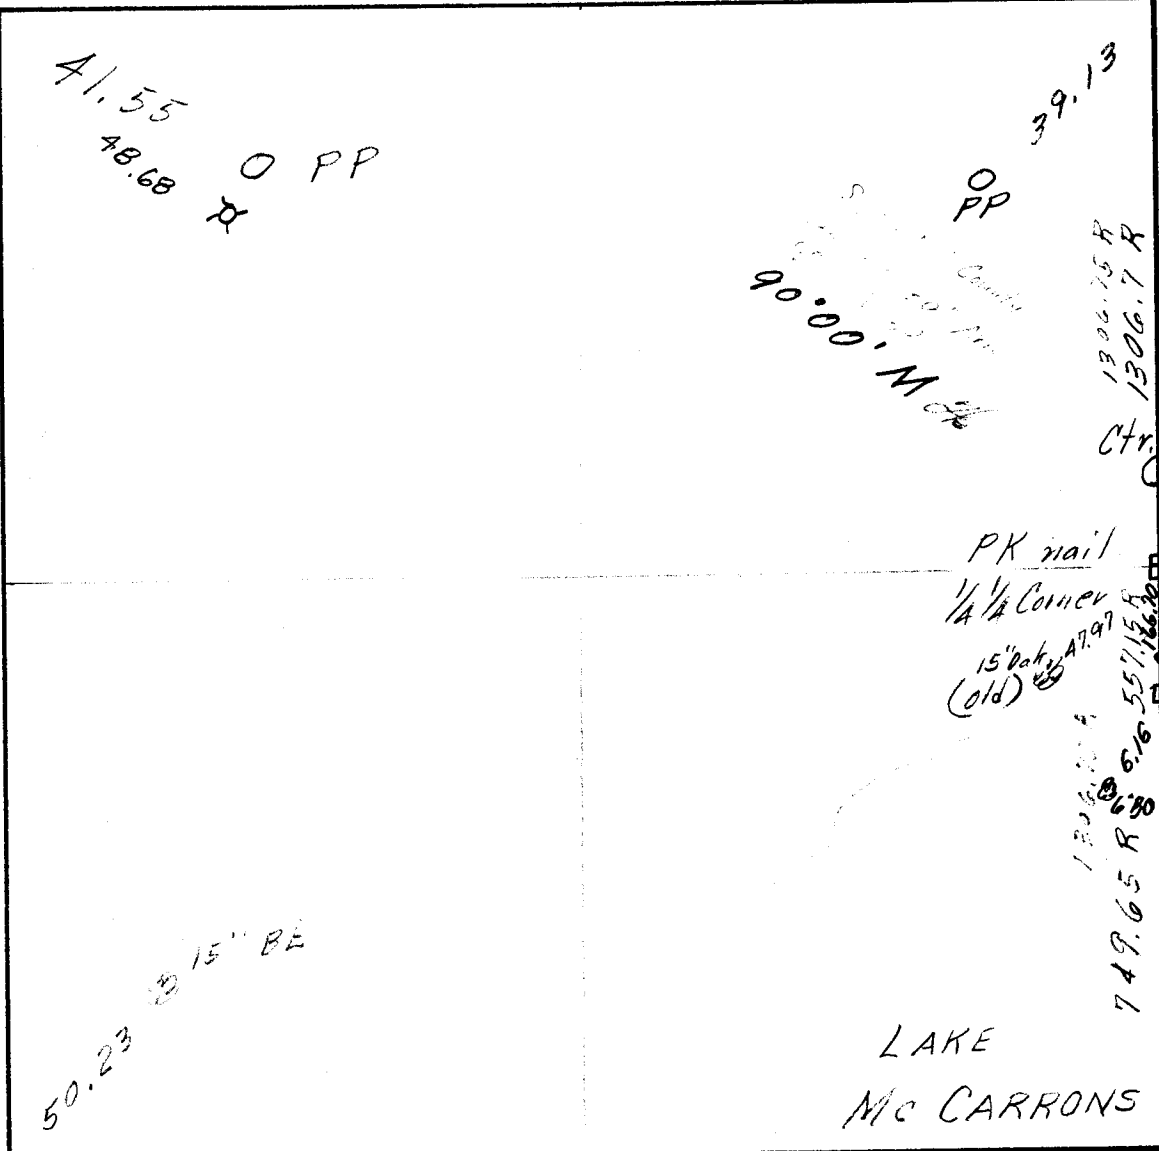

2624.9

C.I. MON

30.14  
 97.33  
 PP

30 [267.03] 33 105.96 107.24

1/4 Corner