


SW 1/4, SEC. 15, TWP. 29, RGE. 23

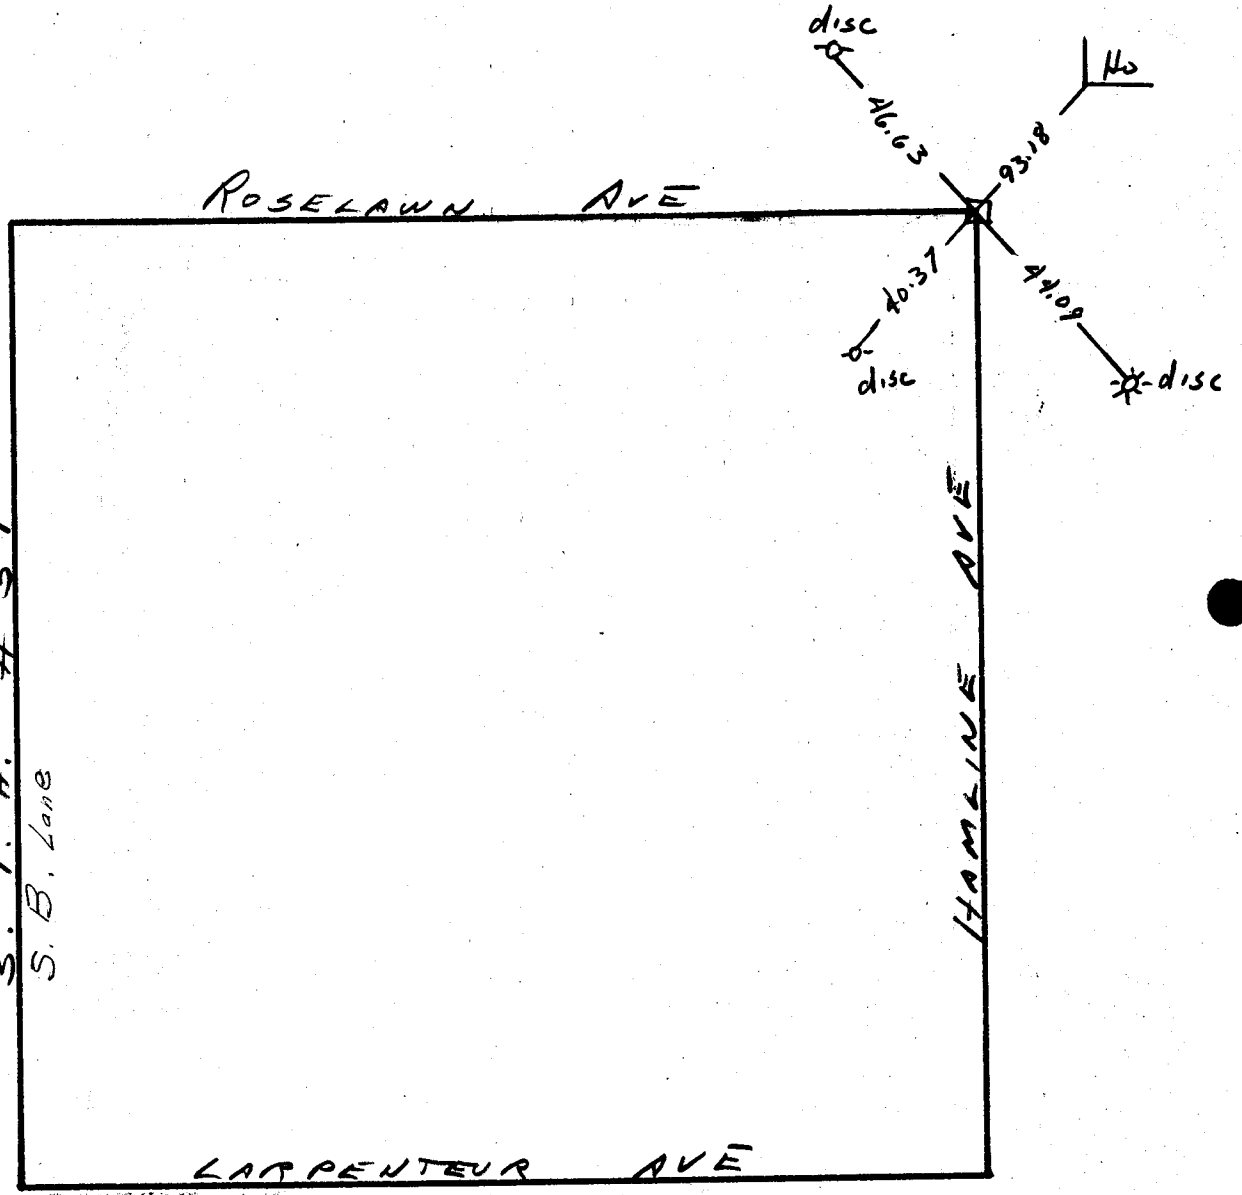

S. T. H. # 51
S. B. Lane

14.75

PP 68.4

73.12

Hyd