


NE 1/4, SEC. 21, TWP. 29, RGE. 23

LARPEN DEUR AVE

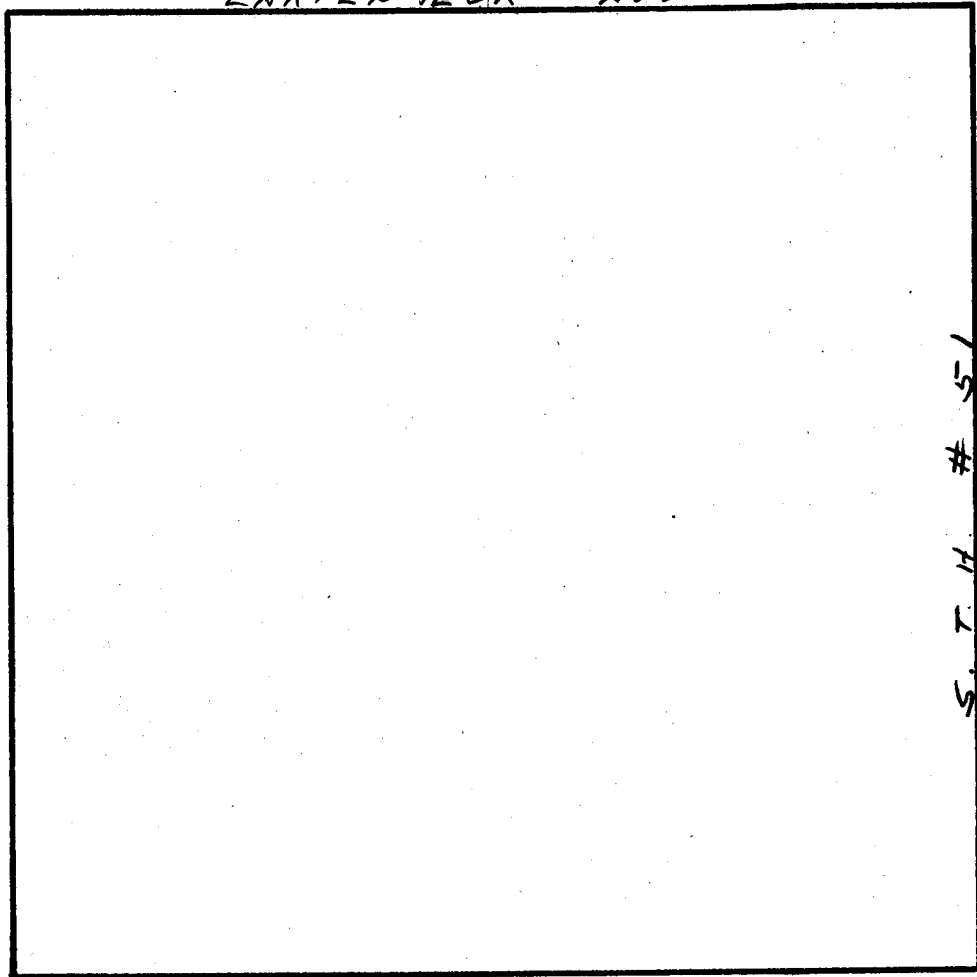

S. T. H. # 51