


SW 1/4, SEC. 21, TWP. 29, RGE. 23

CLEVELAND AVE

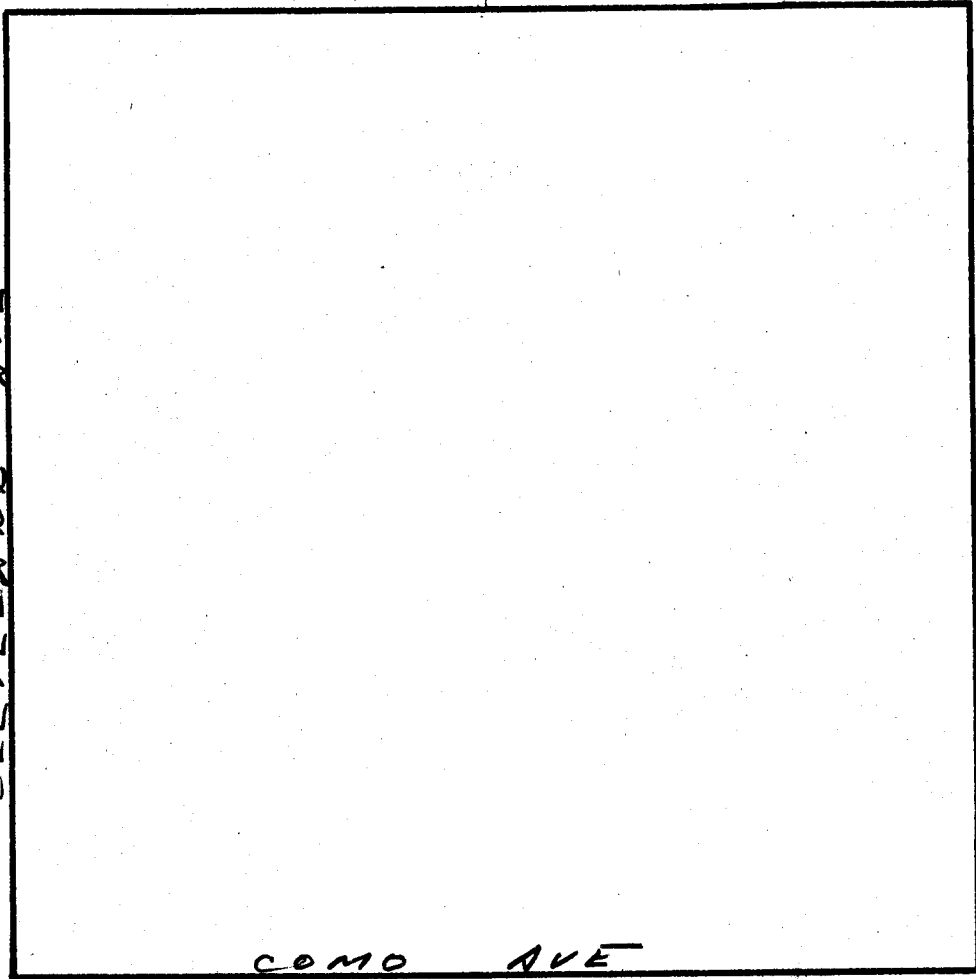

COMO AVE