


NE 1/4, SEC. 5, TWP. 29, RGE. 23

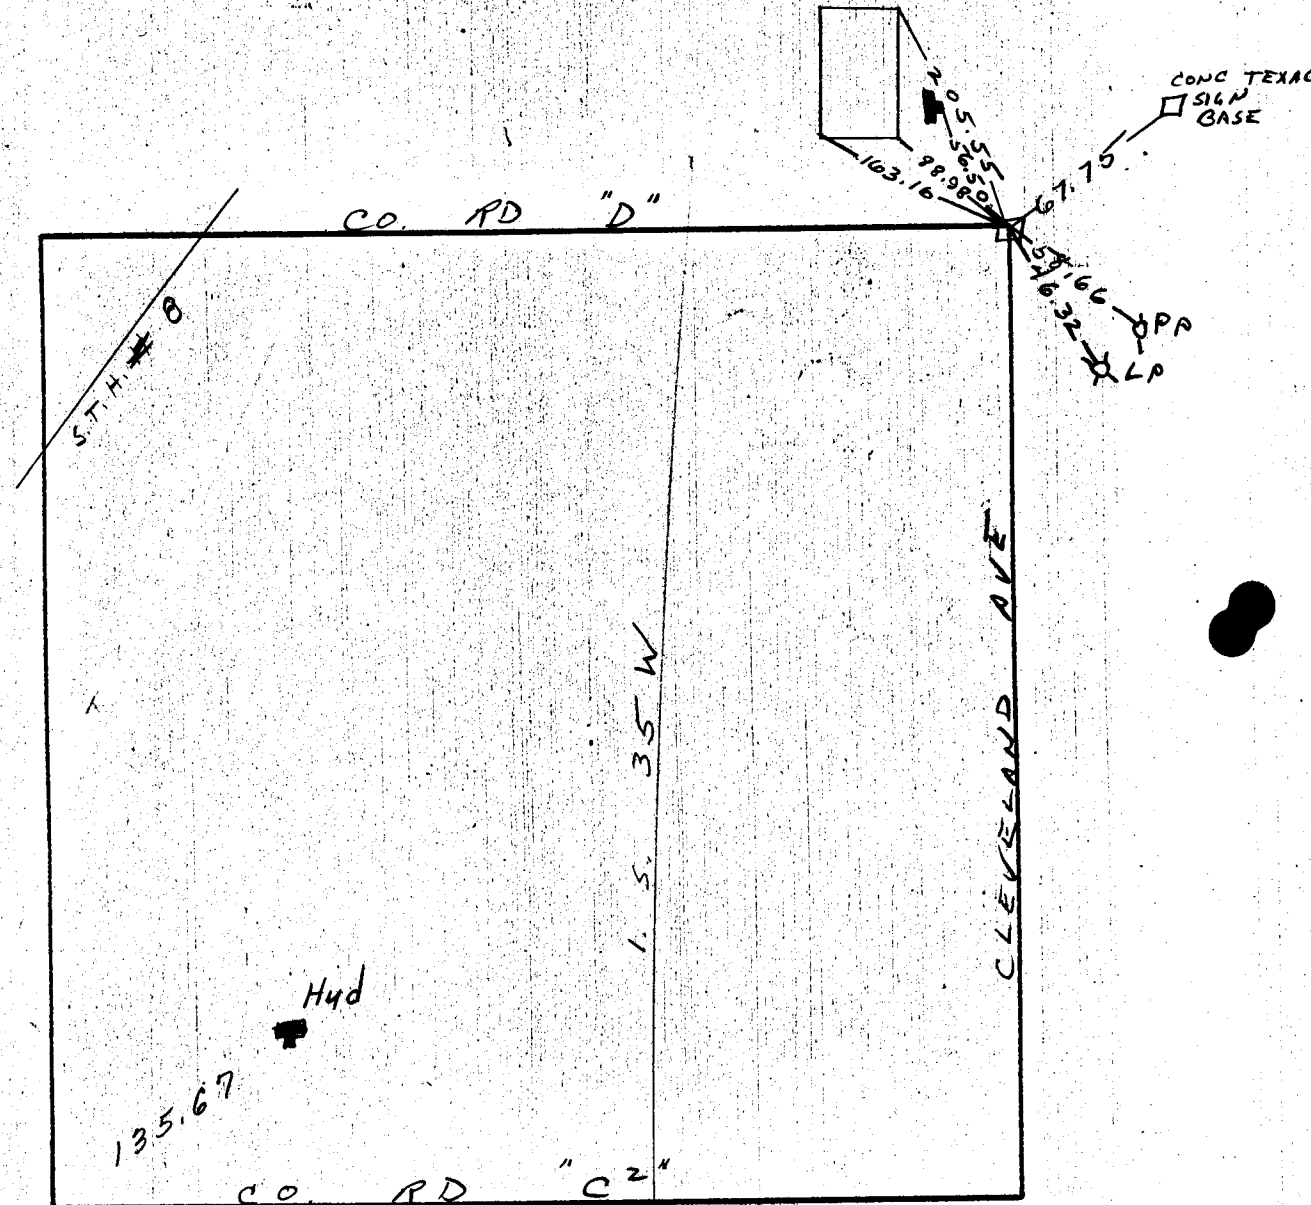

115.03  
54 1/2  
25.04  
66.47  
5.5  
5.5  
Disk  
PP  
post

o  
Disk  
PP