

NW 1/4, SECTION 1, TWP. 30, RGE. 22

4-1965

4-1966


PP  
6" TW  
117.30  
Granite

Sandstone  
PP

45.92 TP

No. Co. LINE

110.18

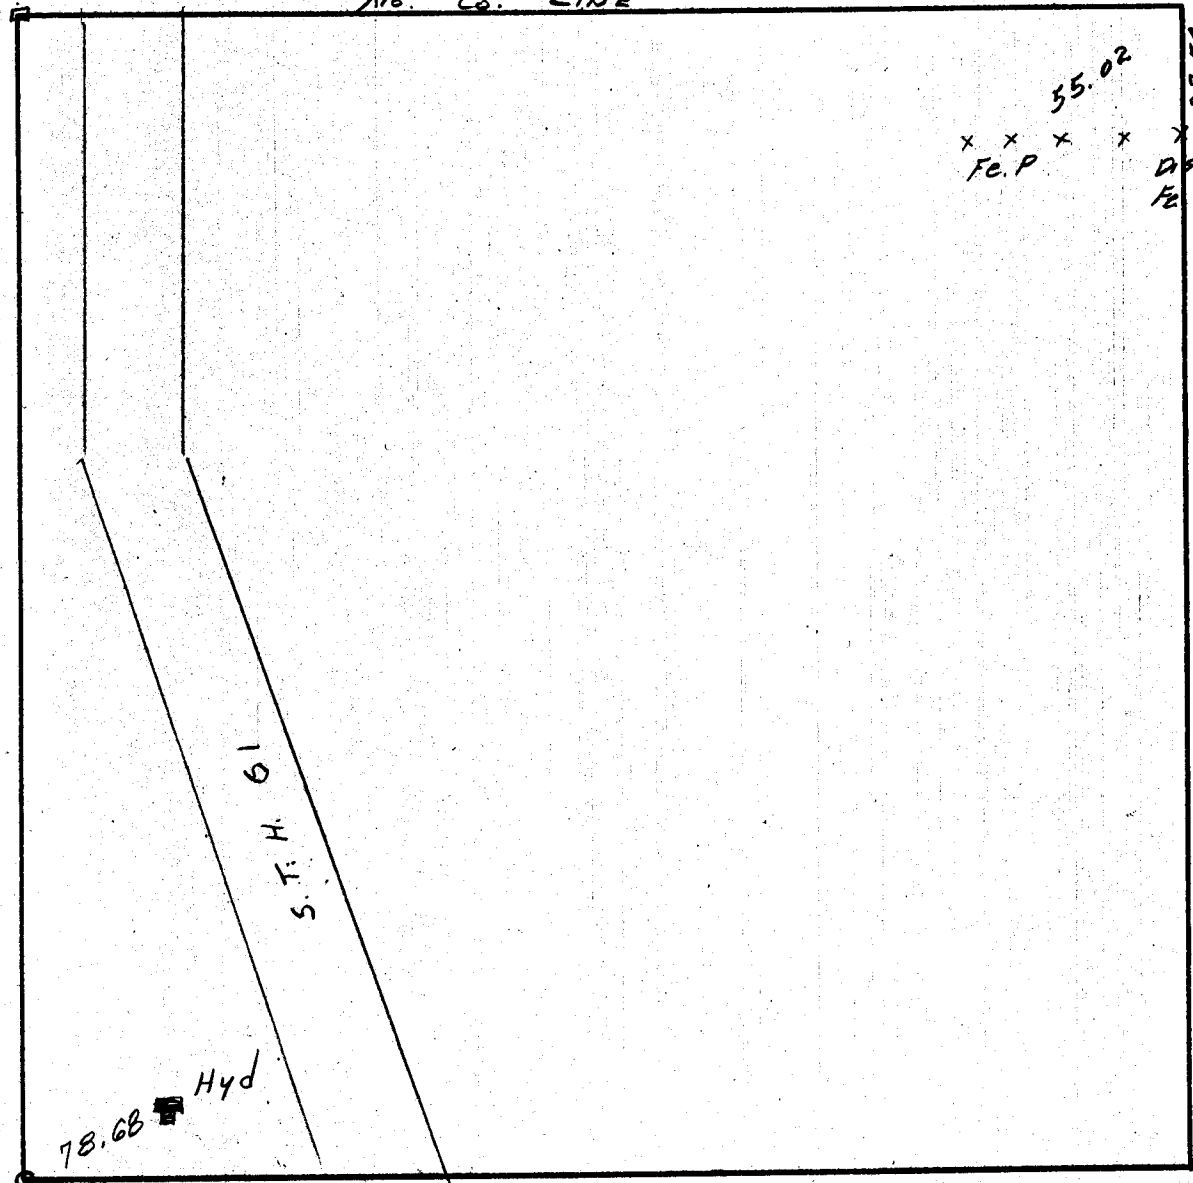

Iron pipe

78.68 Hyd

65.16 Disk Side Tie

35.02  
x x x x  
Fe.P

32.59  
x  
Disk  
Fe.P