


SW 1/4, SECTION 12, TWP. 30, RGE. 22

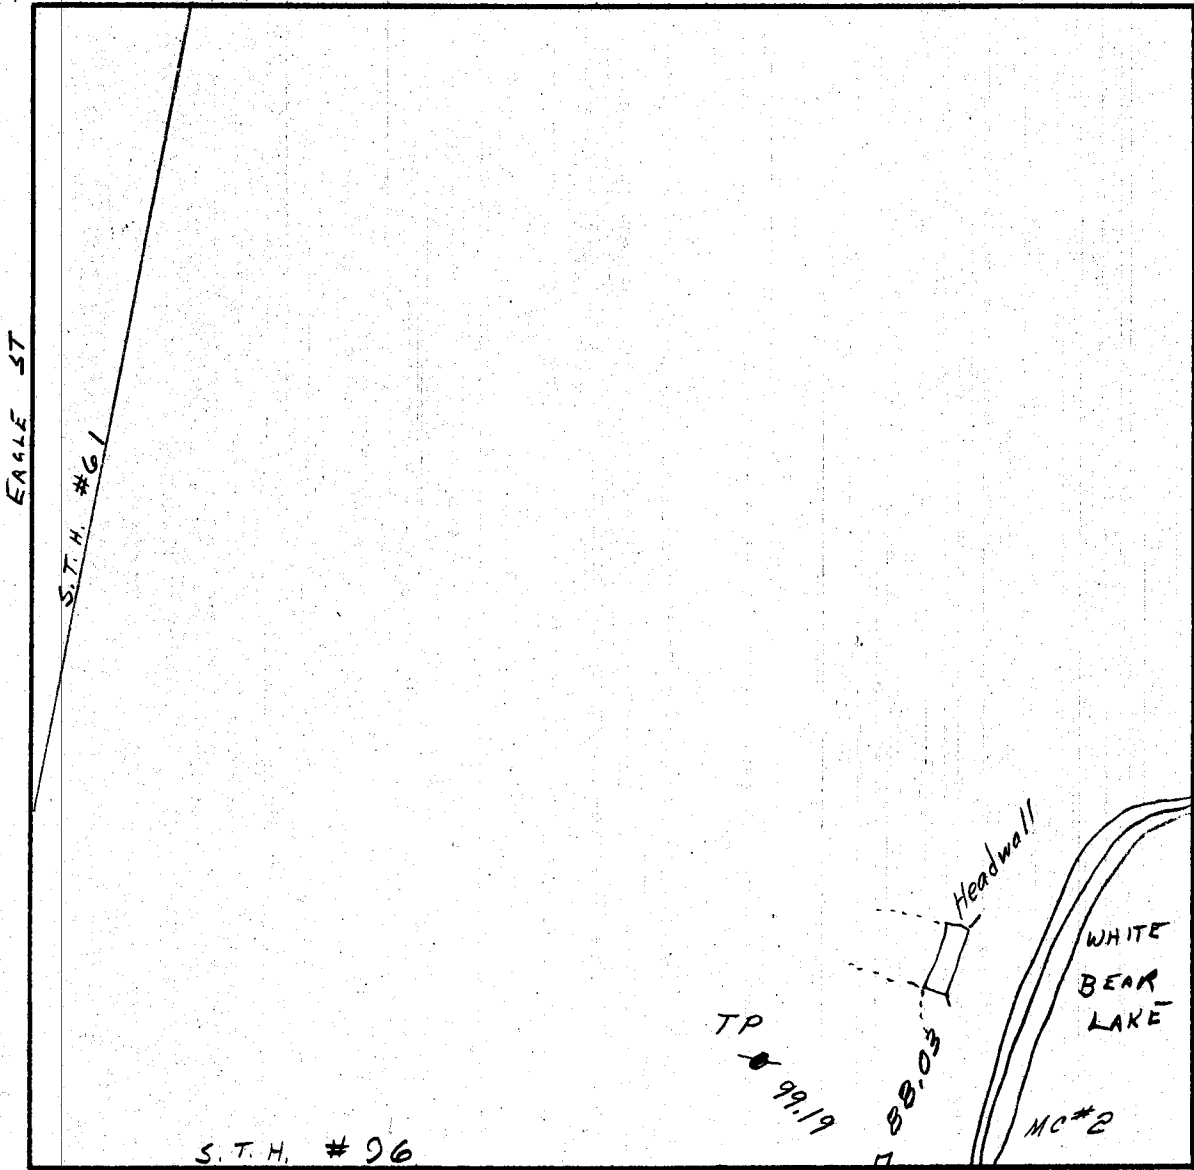

EAGLE ST

S.T.H. #61


TP 99.19

88.03

Headwall

WHITE BEAR LAKE

MC#2

64.91

TP