


NW 1/4, SEC. 14, TWP. 30, RGE. 22

Granite

2656.5 M

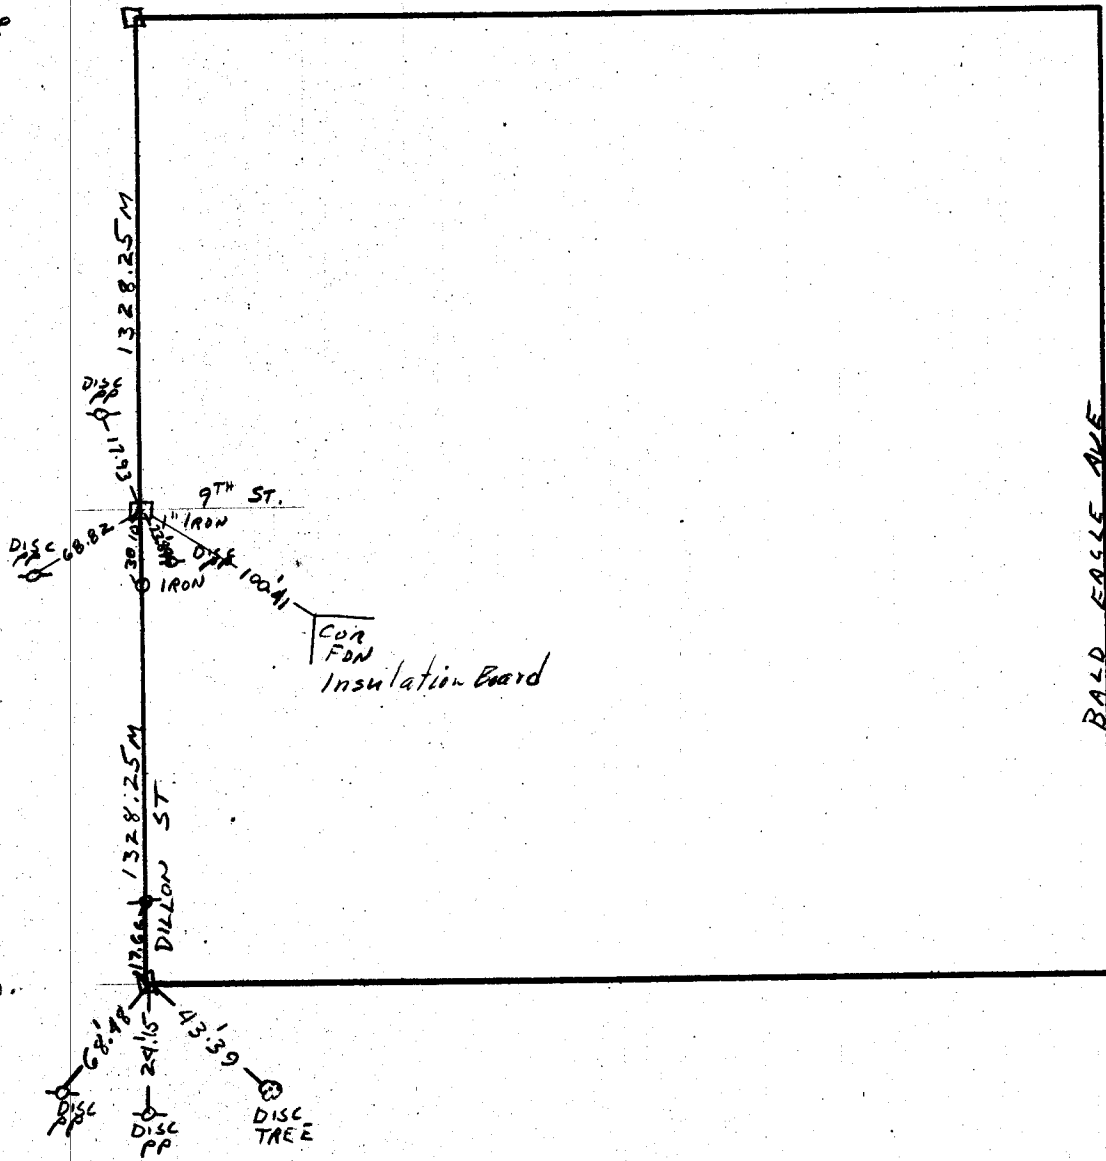

C.I. Mon.