


NW 1/4, SEC. 15, TWP. 30, RGE. 22

CO. RD "H"

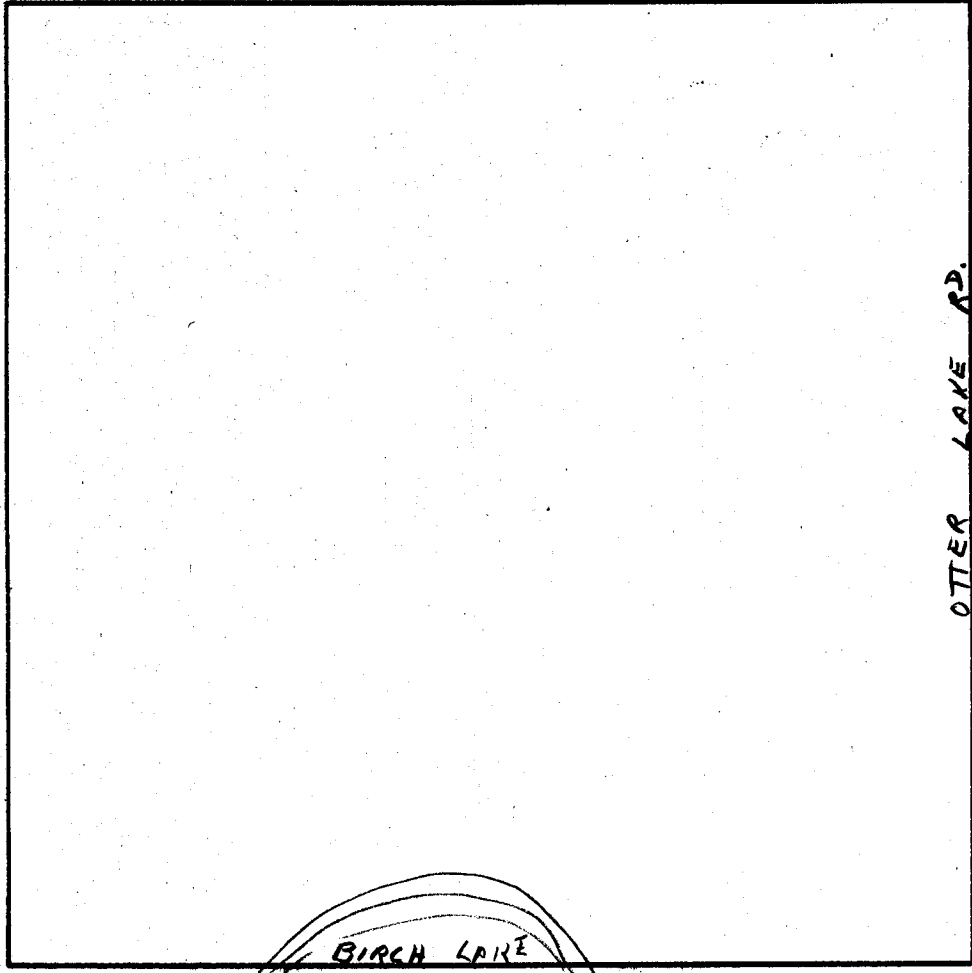

OTTER LAKE RD.

BIRCH LAKE