60
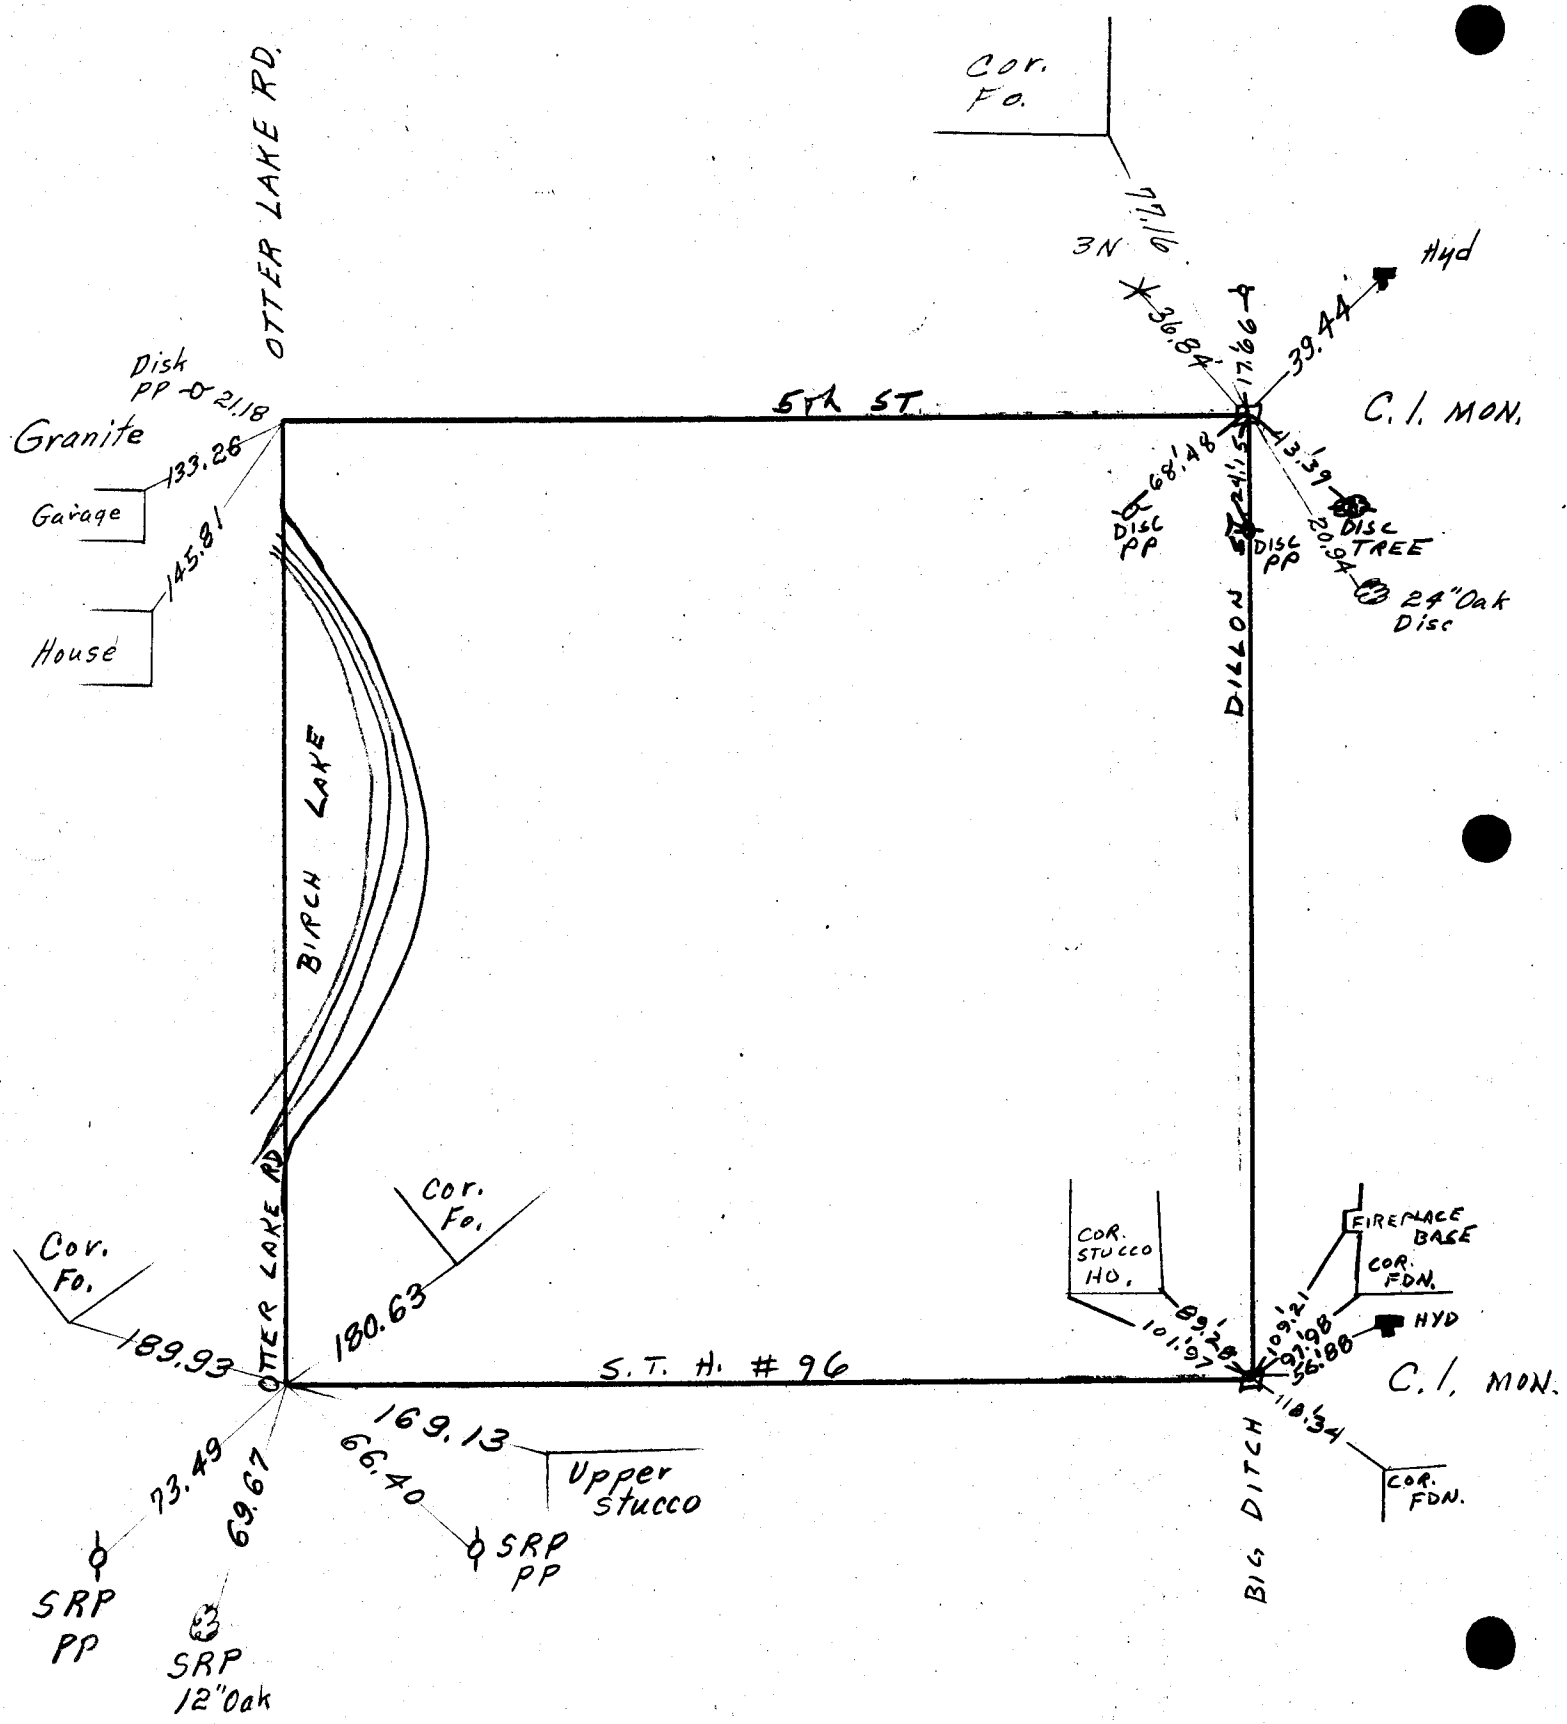
SE 1/4, SEC. 15, TWP. 30, RGE. 22