


NE 1/4, SEC. 17, TWP. 30, RGE. 22

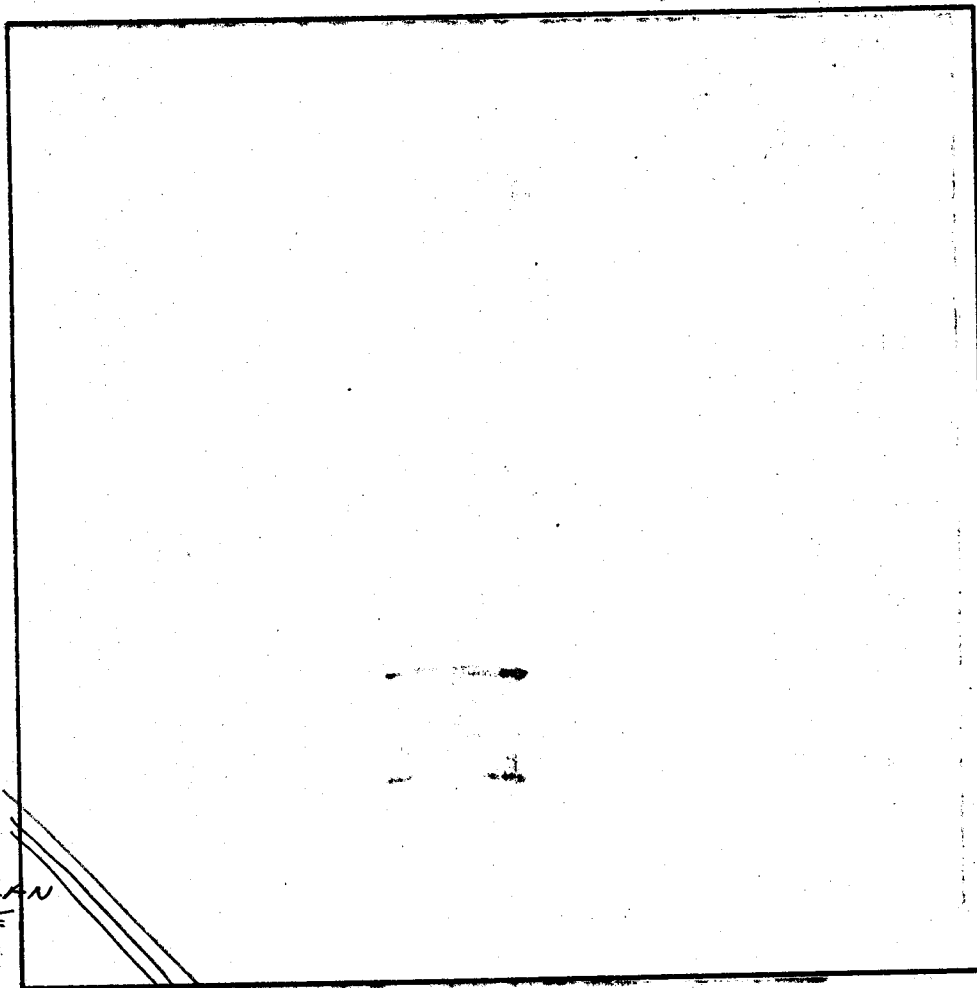

GILFILLAN  
LAKE