


8

SE 1/4, SECTION 2, TWP. 30, RGE. 22

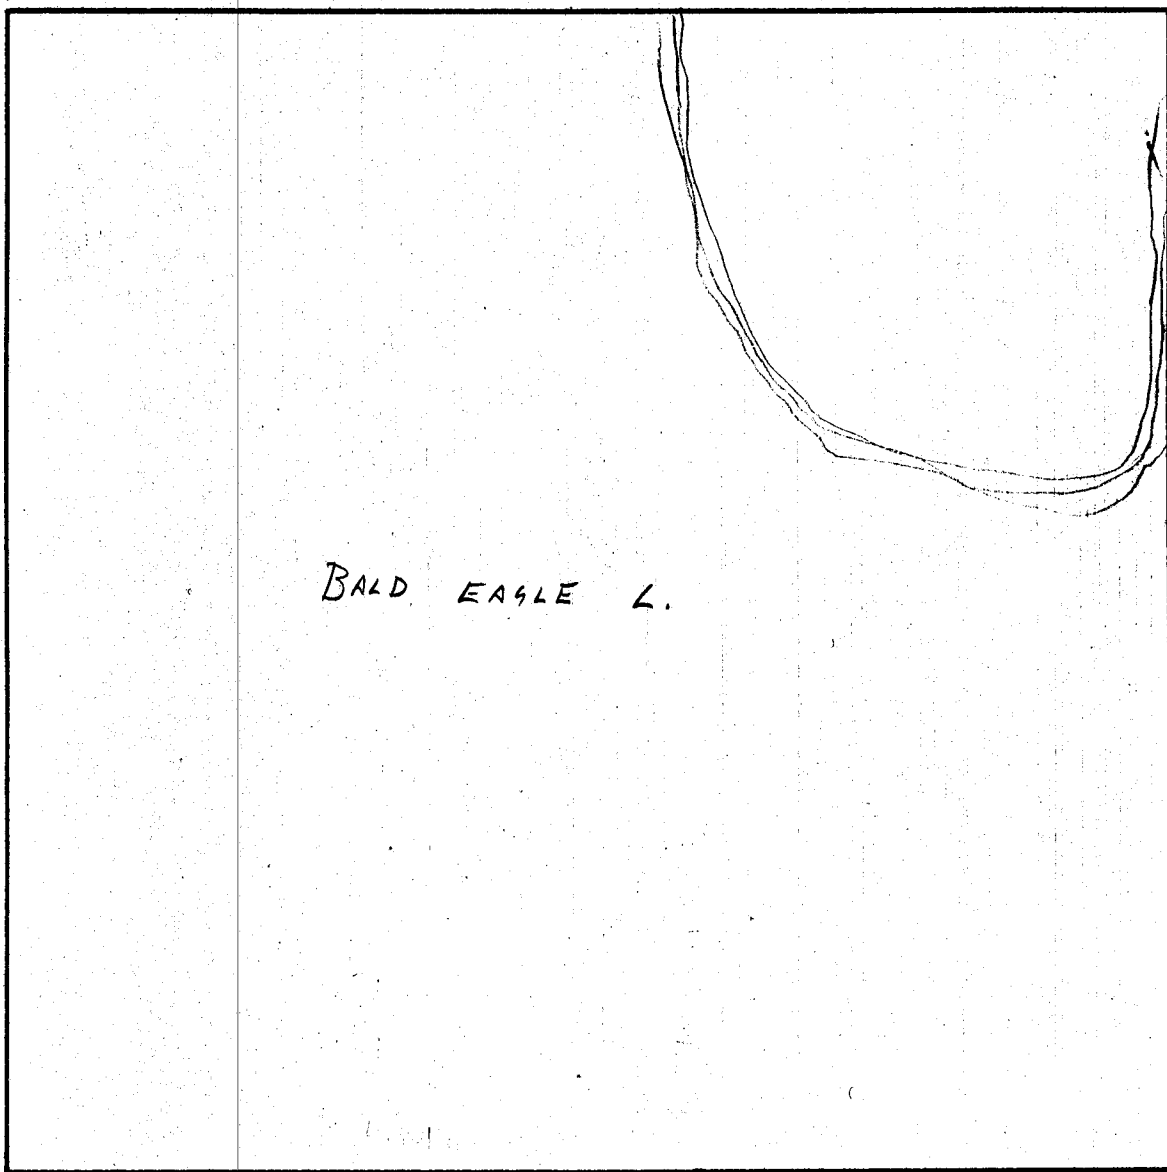

BALD EAGLE L.

Hyd
78.68
Iron
Pipe
65.16
A
Disk
side Tie