


NE 1/4, SEC. 20, TWP. 30, RGE. 22

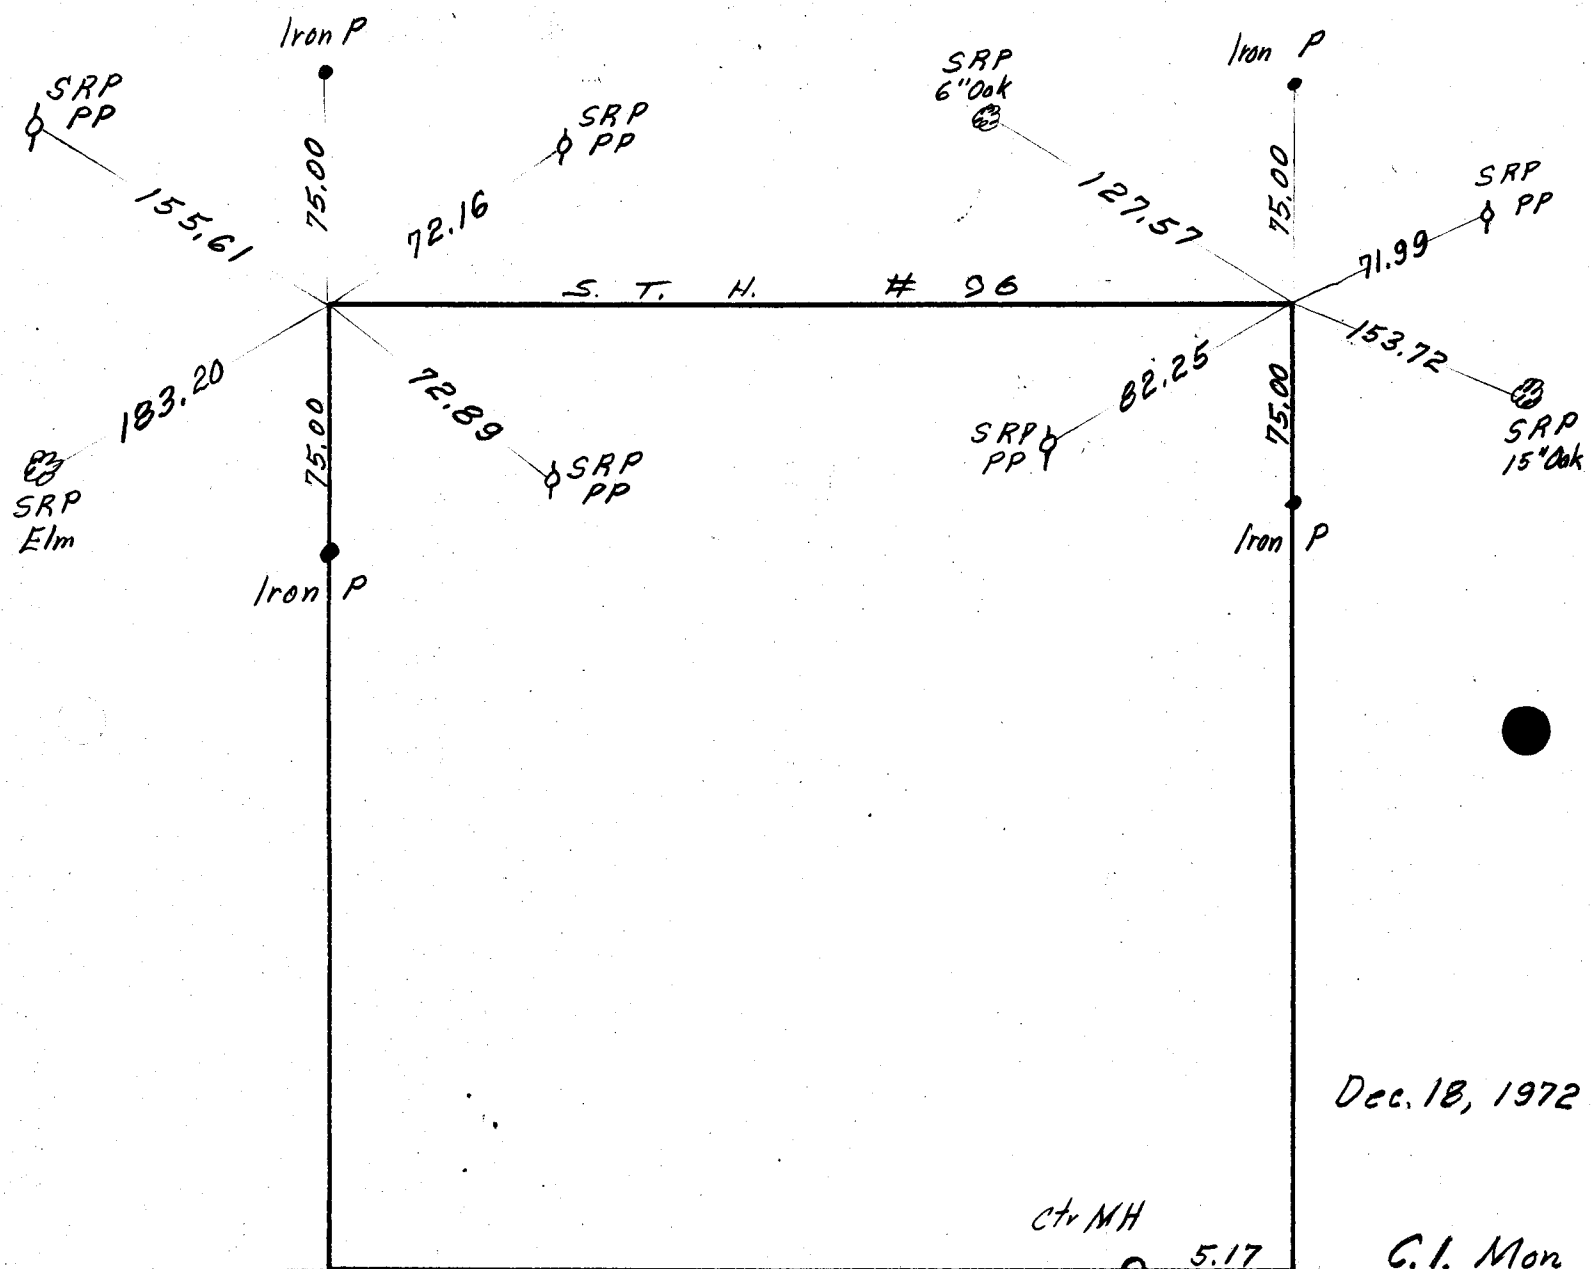

Dec. 18, 1972

G. I. Mon

144.71
 3N
 ST
 14" Oak

105.32
 3N
 10" W. OAK

9.11 Roofing Nail
 1.11.10
 * 2" NP
 *
 3N
 ST
 2" NP