


S.W 1/4, SEC. 20, TWP. 30, RGE. 22

Mc MENEMY RD

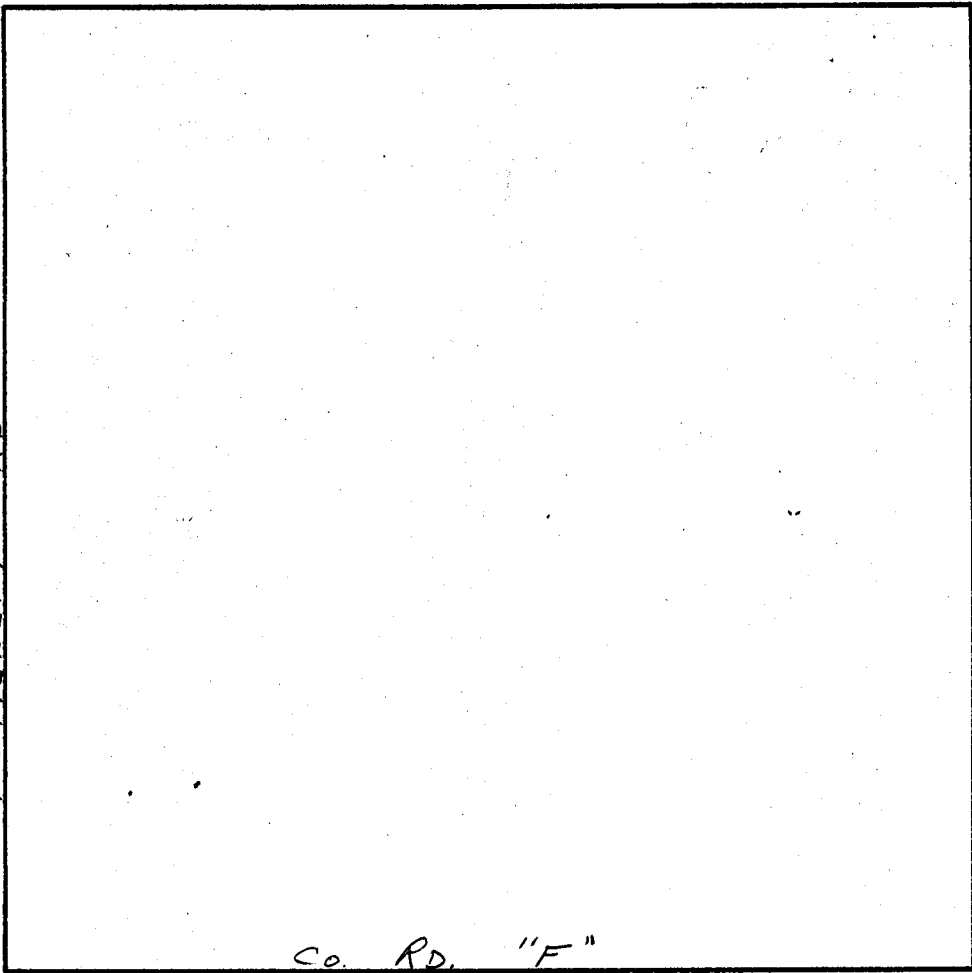

Co. Rd. "F"