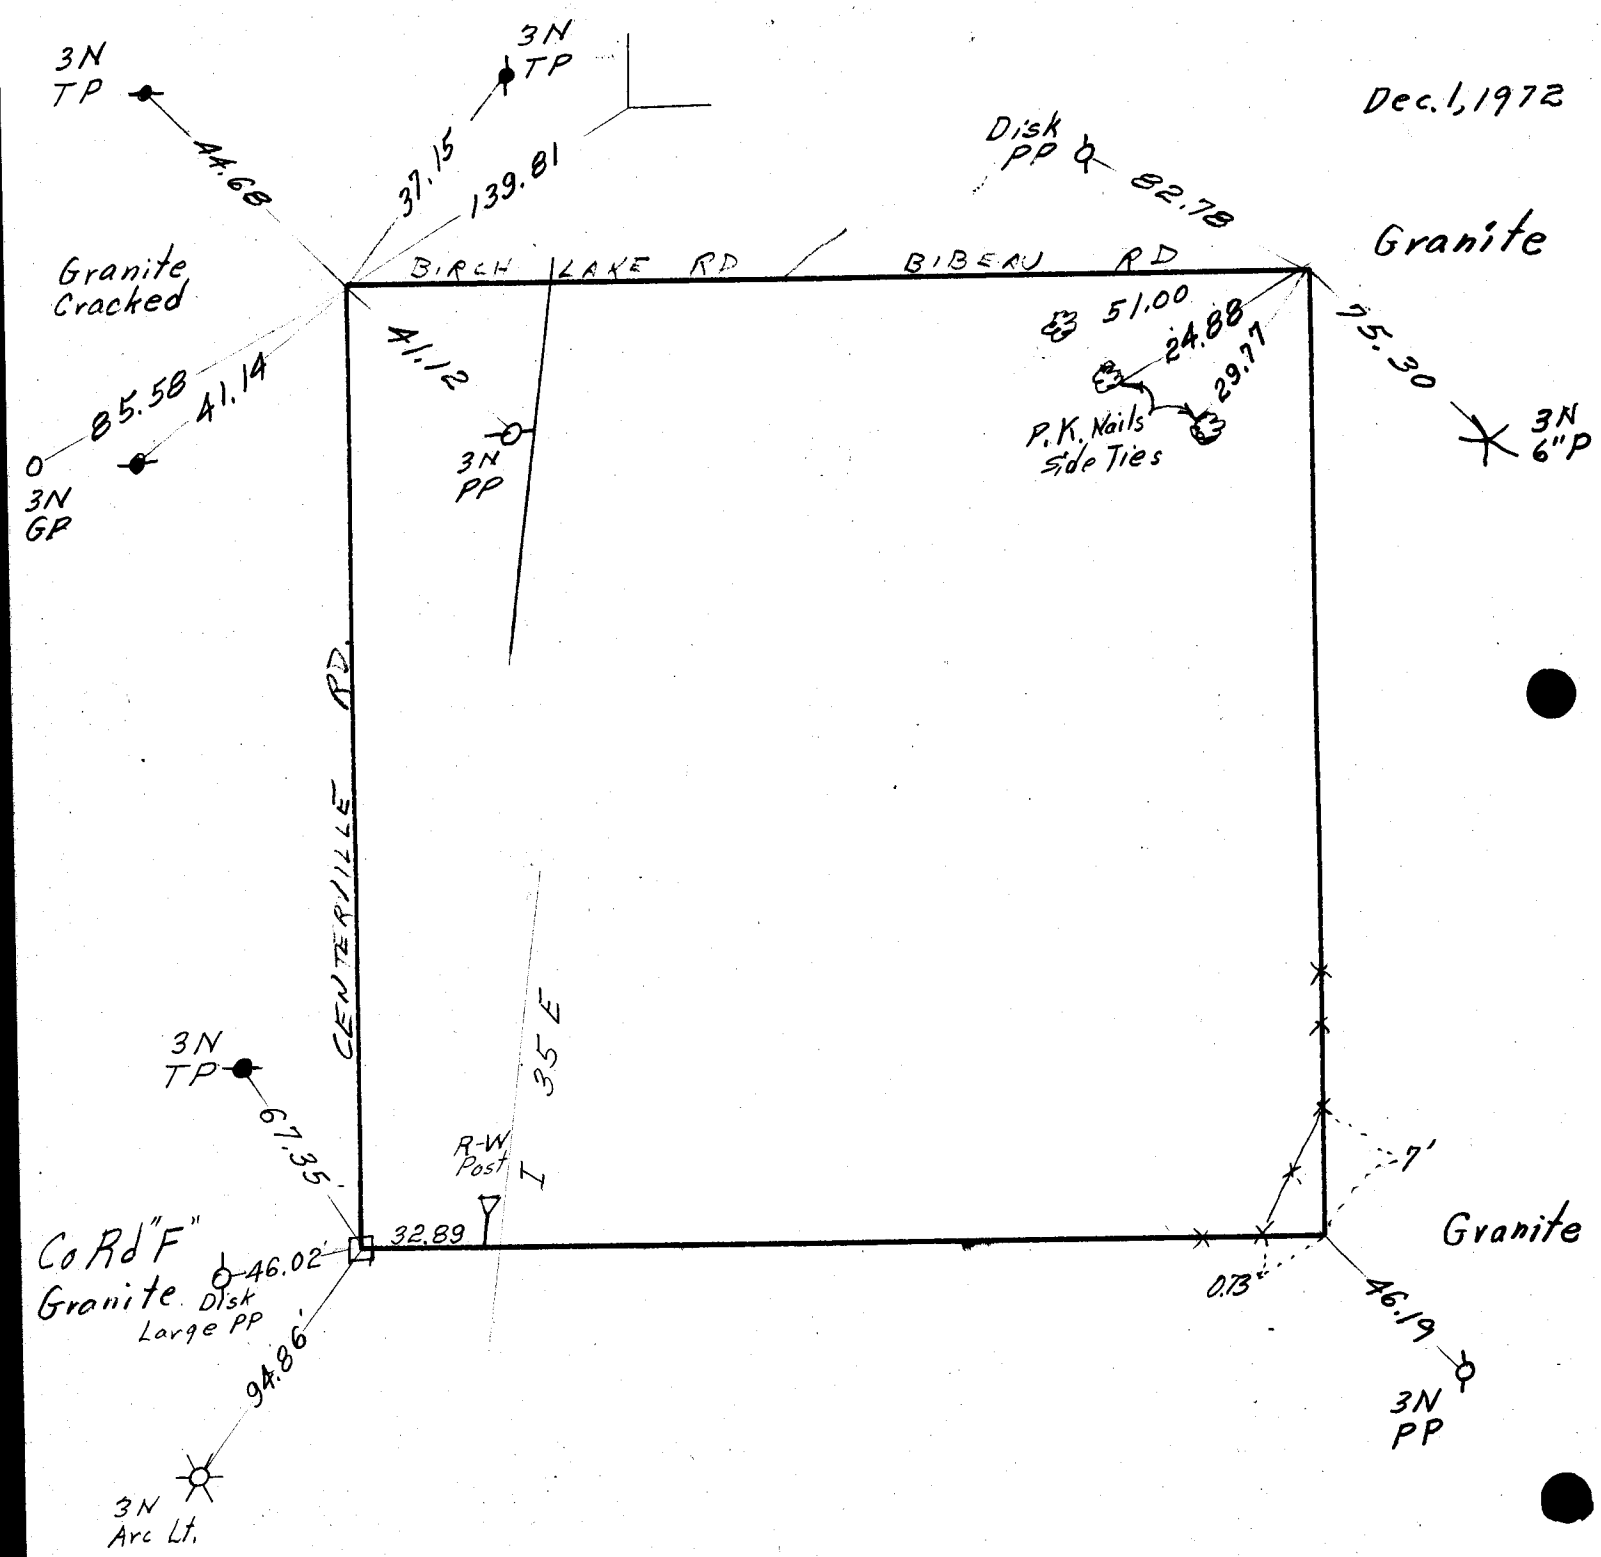SE 1/4, SEC. 21, TWP. 30, RGE. 22