


SE 1/4, SEC. 23, TWP. 30, RGE. 22

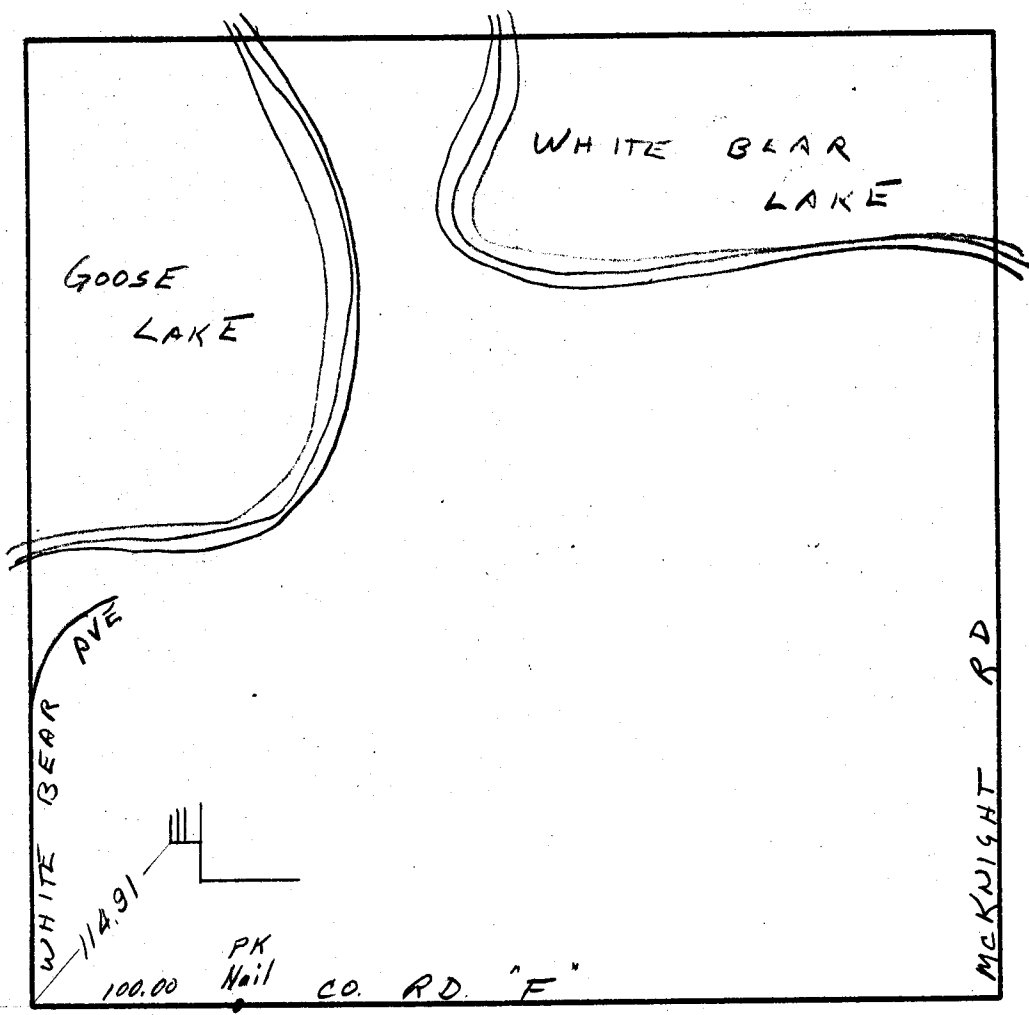

PK
•
Nail

100.00

100.00

PK
Nail

CO. RD. "F"

MCKNIGHT RD