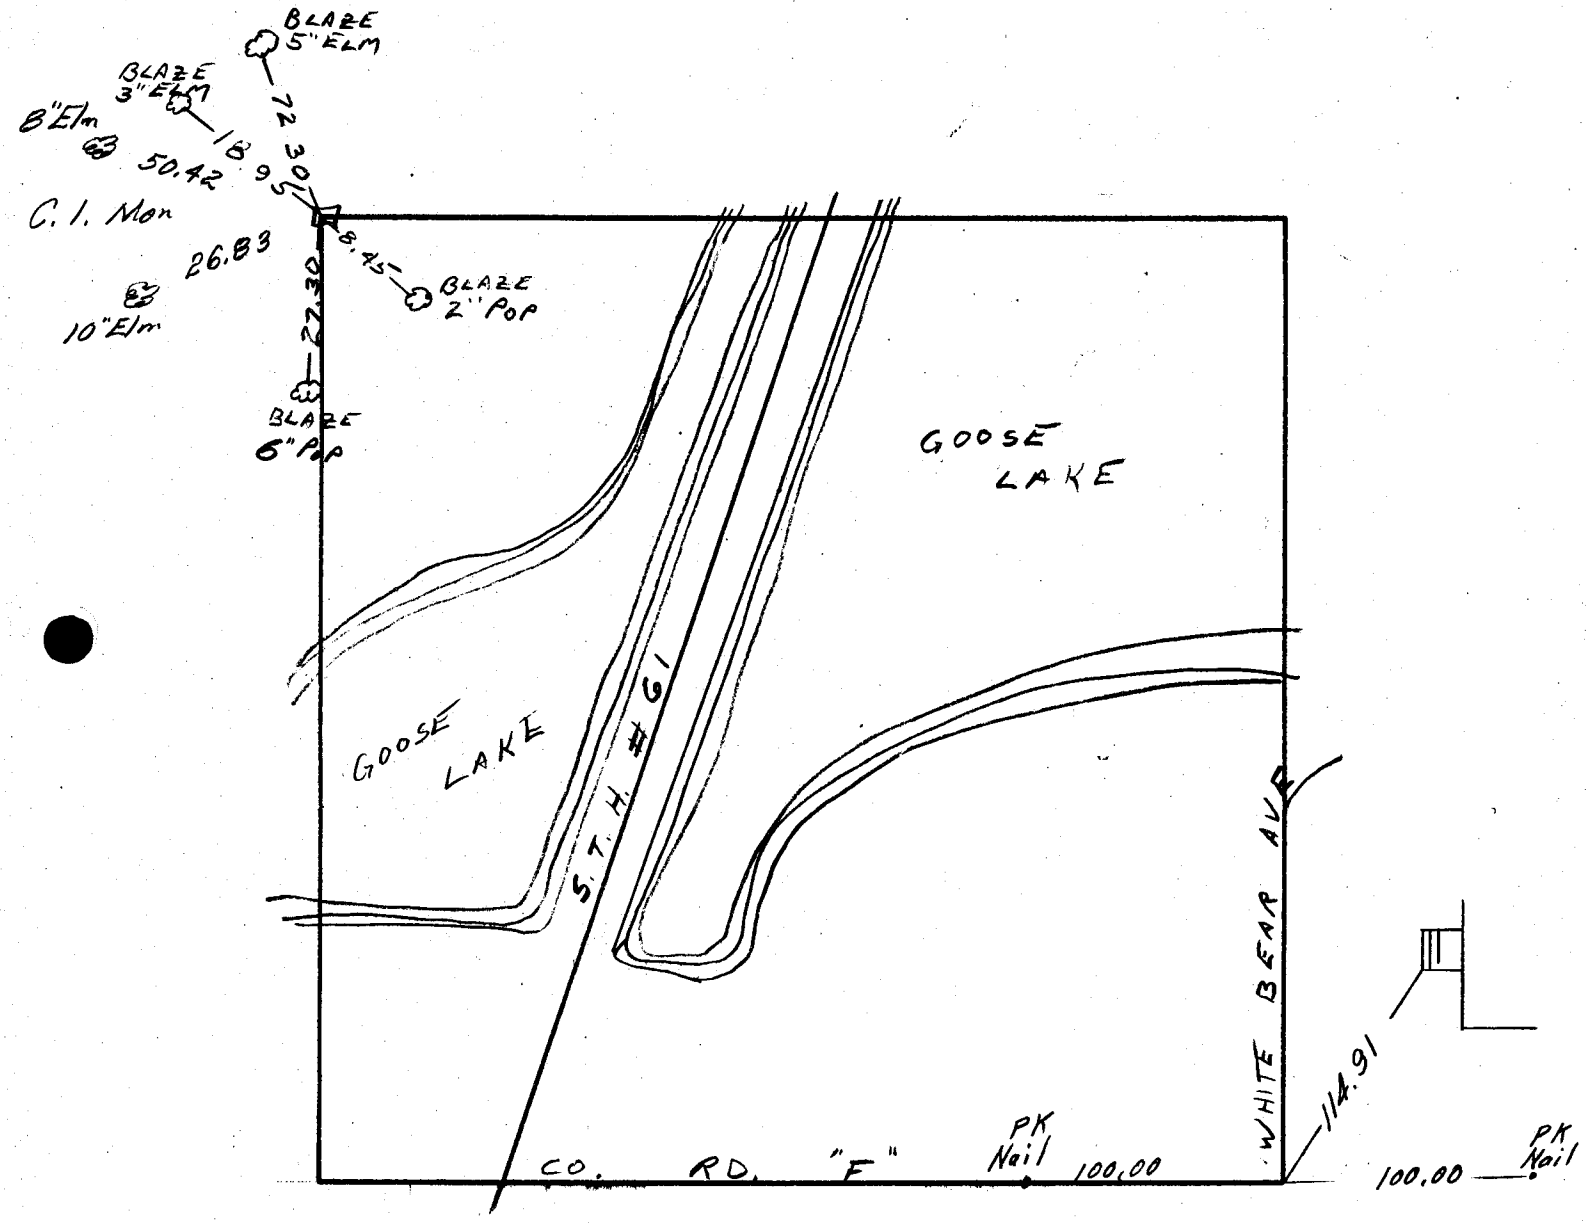S.W. 1/4, SEC. 23, TWP. 30, RGE. 22