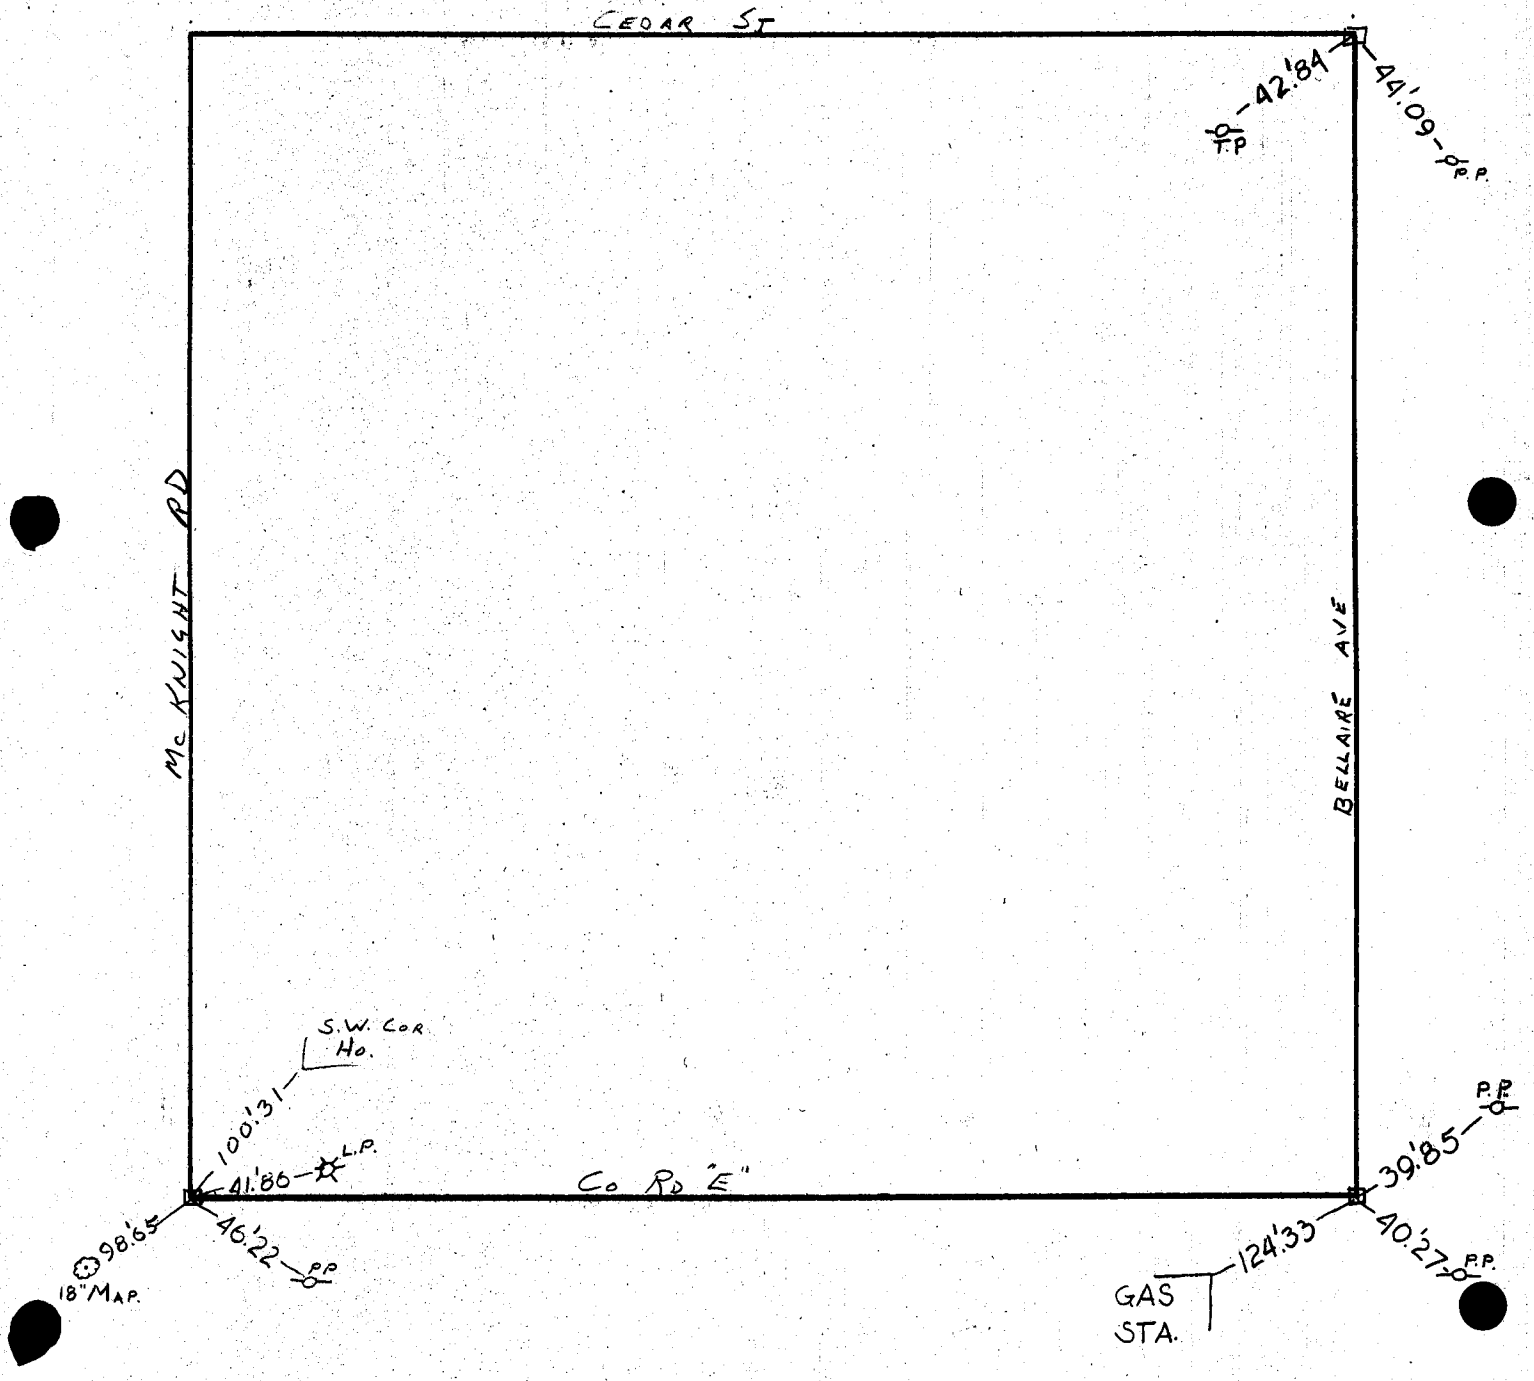SW 1/4, SECTION 25, TWP. 30, RGE. 22