


SE 1/4, SEC. 28, TWP. 30, RGE. 22

I.S. 35 E

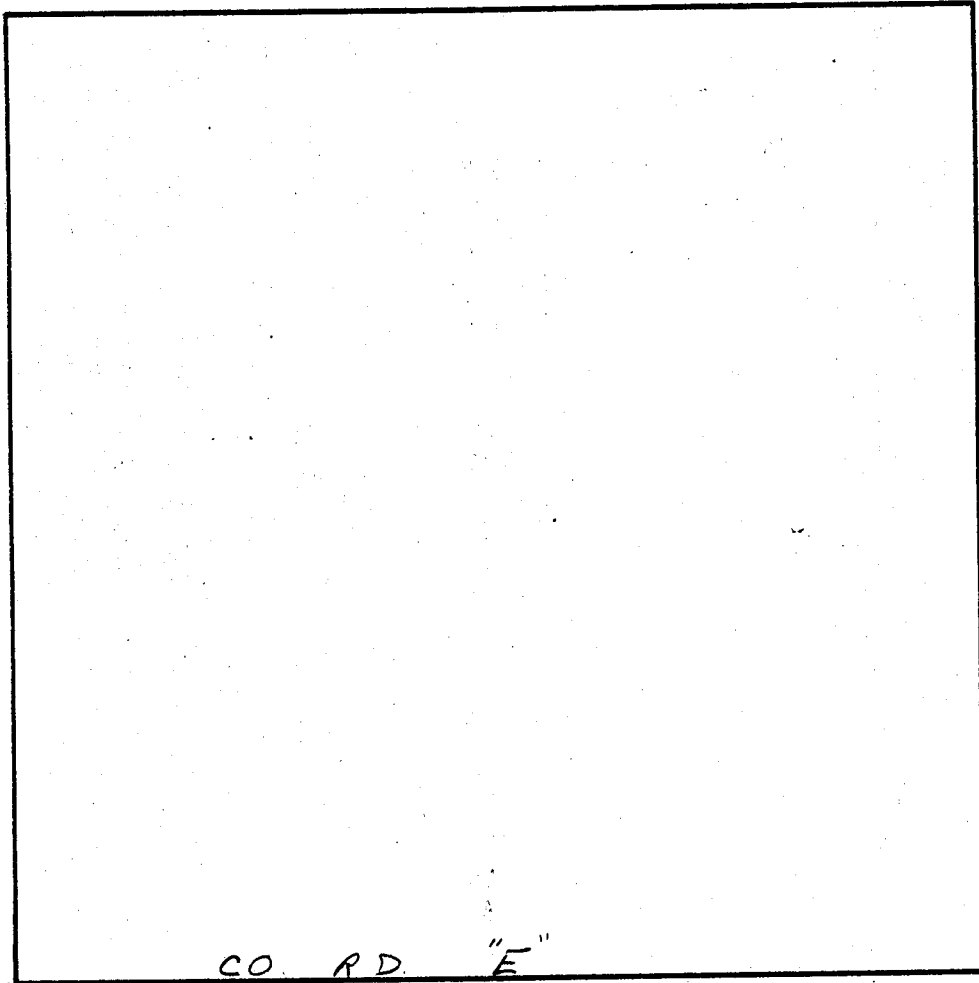

CO. RD. "E"