


NE 1/4, SEC. 29, TWP. 30, RGE. 22

Co. RD. "F"

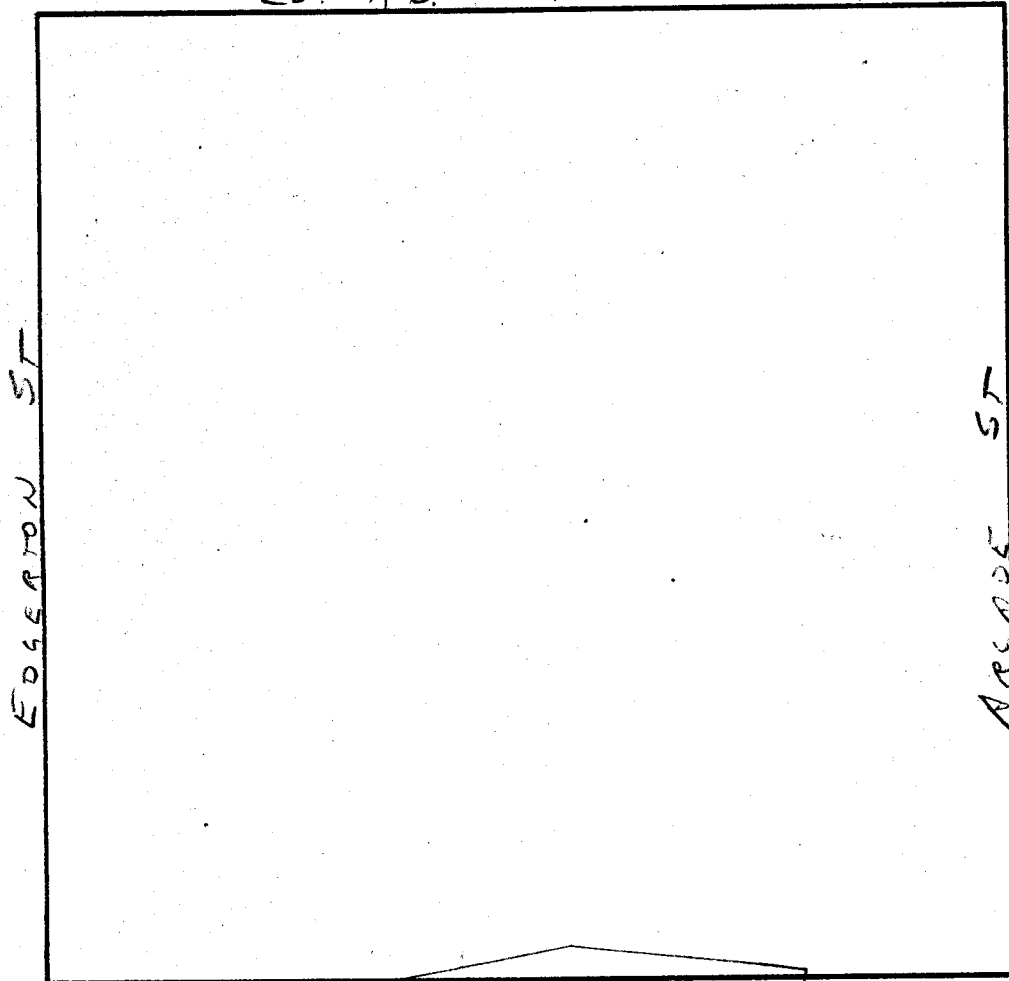

STOCKDALE RD