




SE 1/4, SEC. 29, TWP. 30, RGE. 22

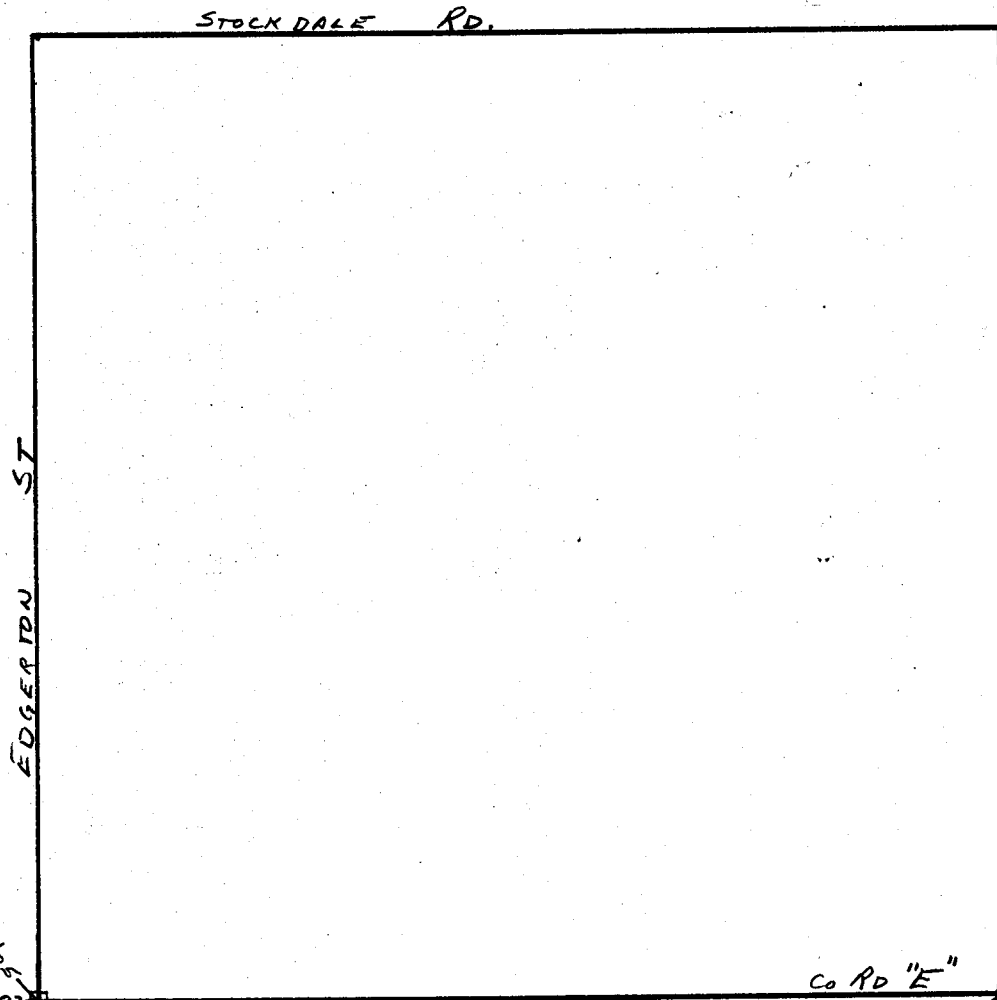

S.E. COR. NORTHERNMOST  
PILLAR  
No # 3605

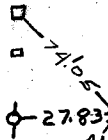

N.E. COR  
No # 3594

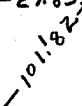

N.W. COR  
No



Co RD "E"

