


118

NE 1/4, SEC. 30, TWP. 30, RGE. 22

Co. Rd. "F"

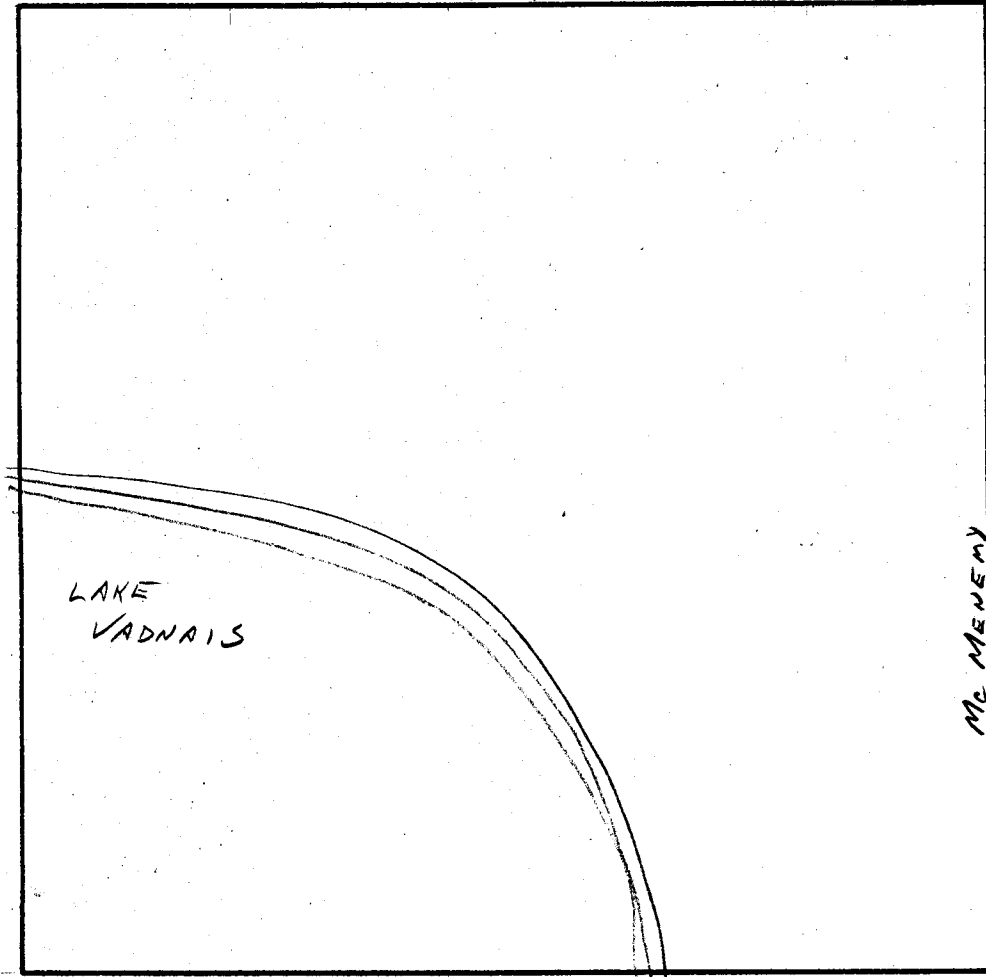

LAKE
VADNAIS

MC MENEY