


NE 1/4, SEC. 33, TWP. 30, RGE. 22

Co RD "E"

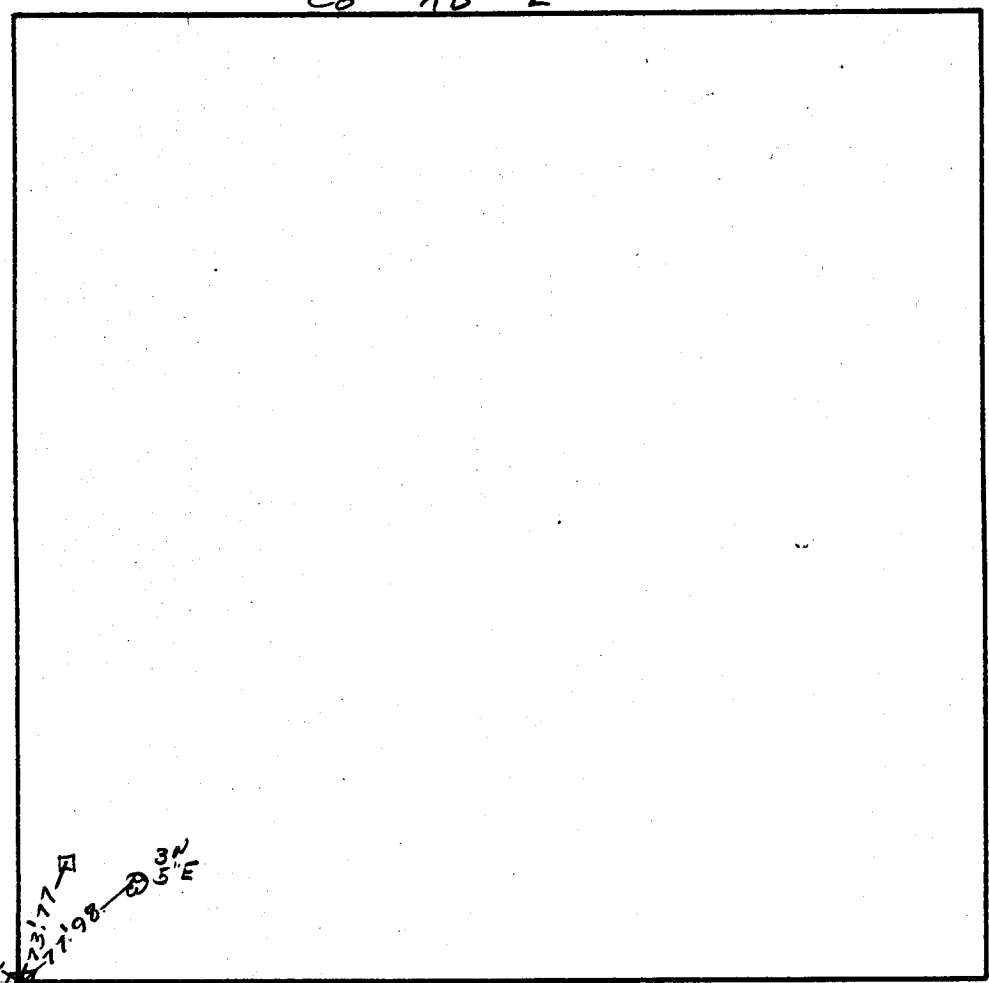

2x2 Hubs
72.24
3N 5"E
71.98
33.77
3N 2"NP
53.65
3N 2"SPRUCE
16.16
C. I. Man.