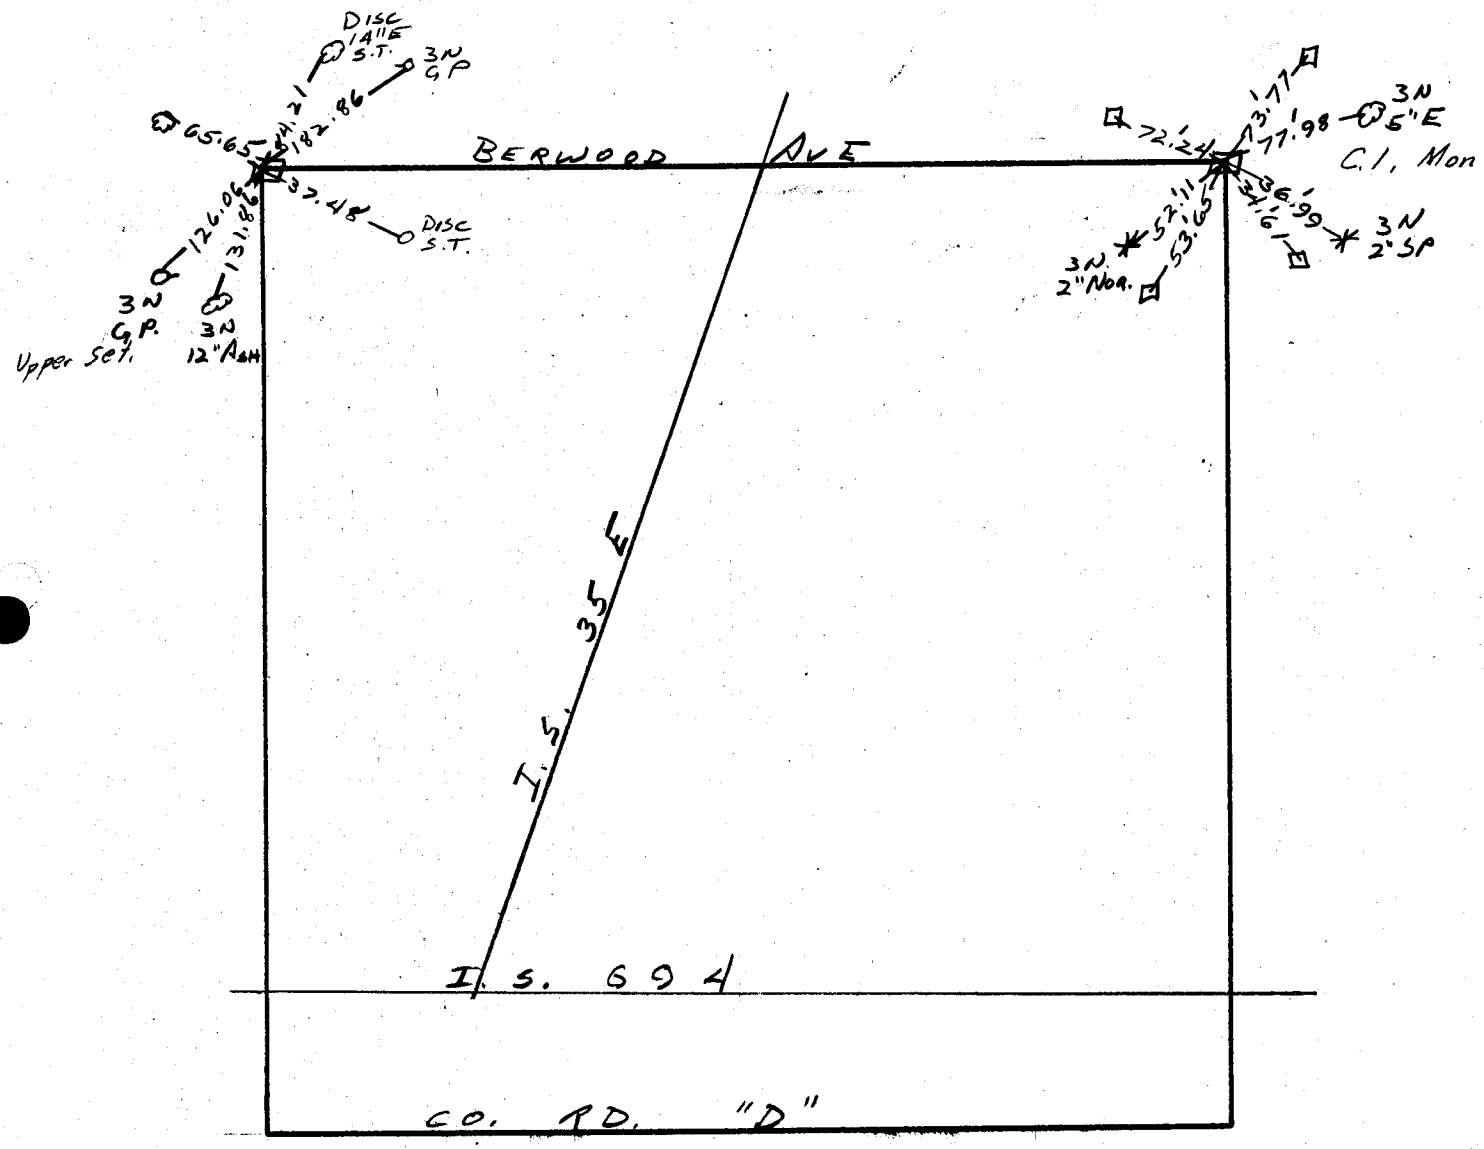SW 1/4, SEC. 33, TWP. 30, RGE. 22