


NW 1/4, SEC. 34, TWP. 30, RGE. 22

CO. RD. "E"

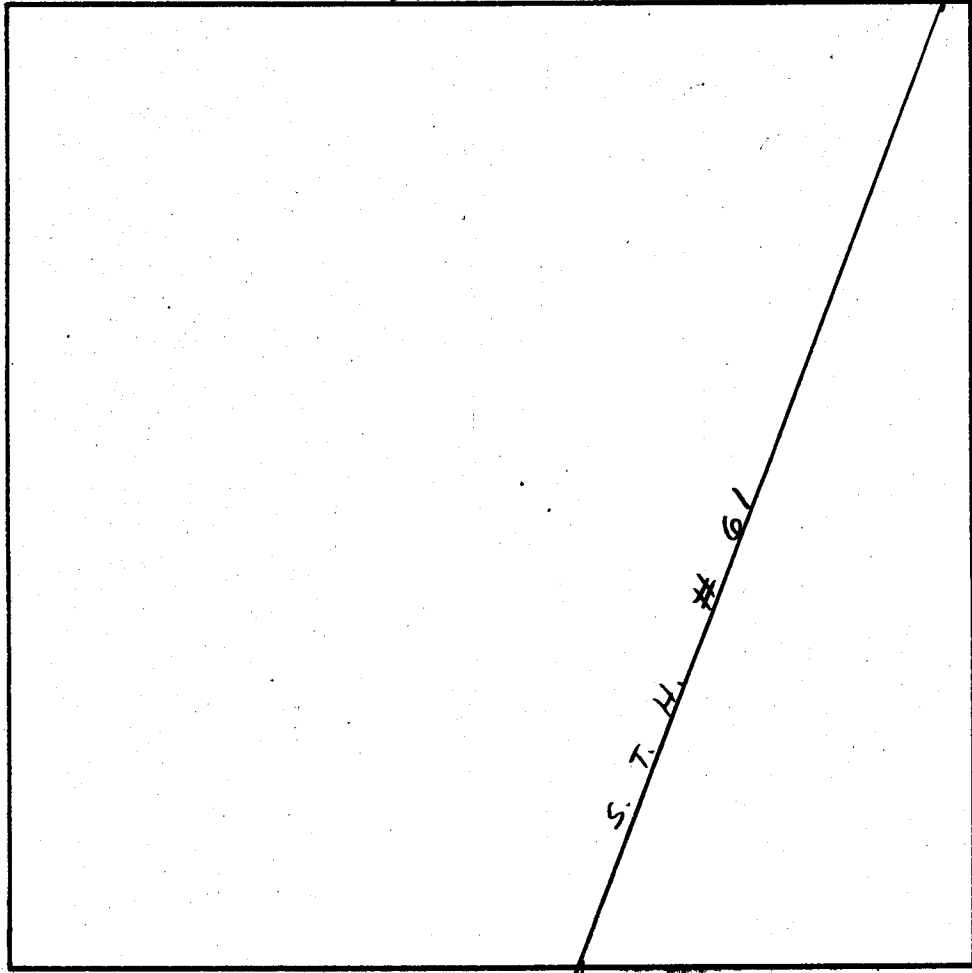

S. T. H. # 61