


SE1/4, SEC. 34, TWP. 30, RGE. 22

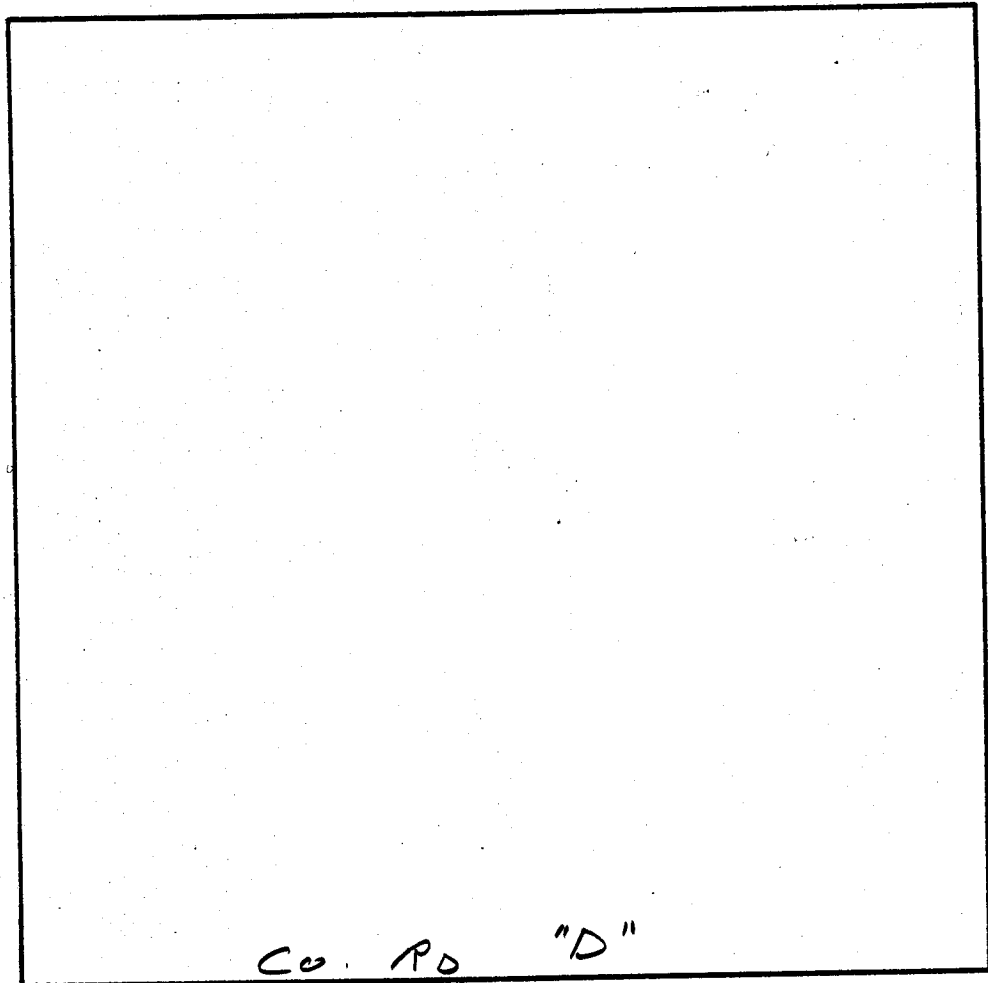

Co. RD "D"