


SW 1/4, SEC. 4, TWP. 30, RGE. 22

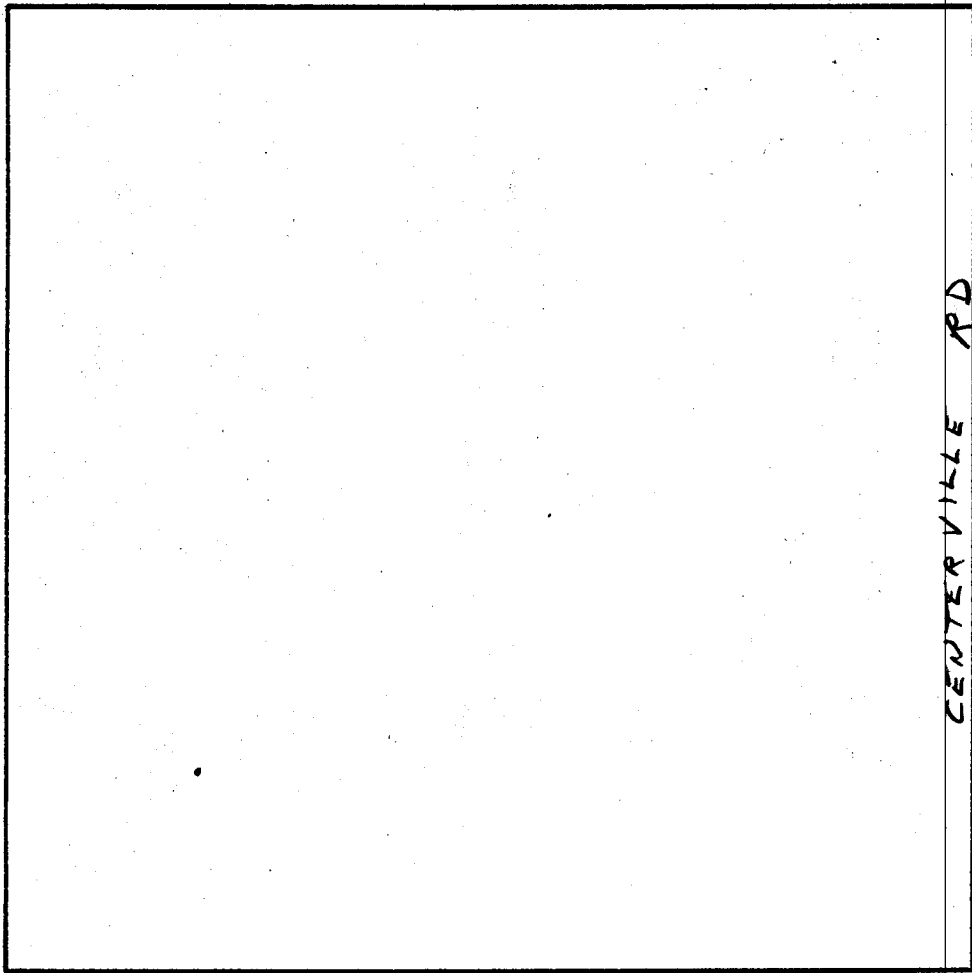

CENTERVILLE RD