


NE 1/4, SEC. 6, TWP. 30, RGE. 22

No. CO. LINE

TURTLE LAKE RD

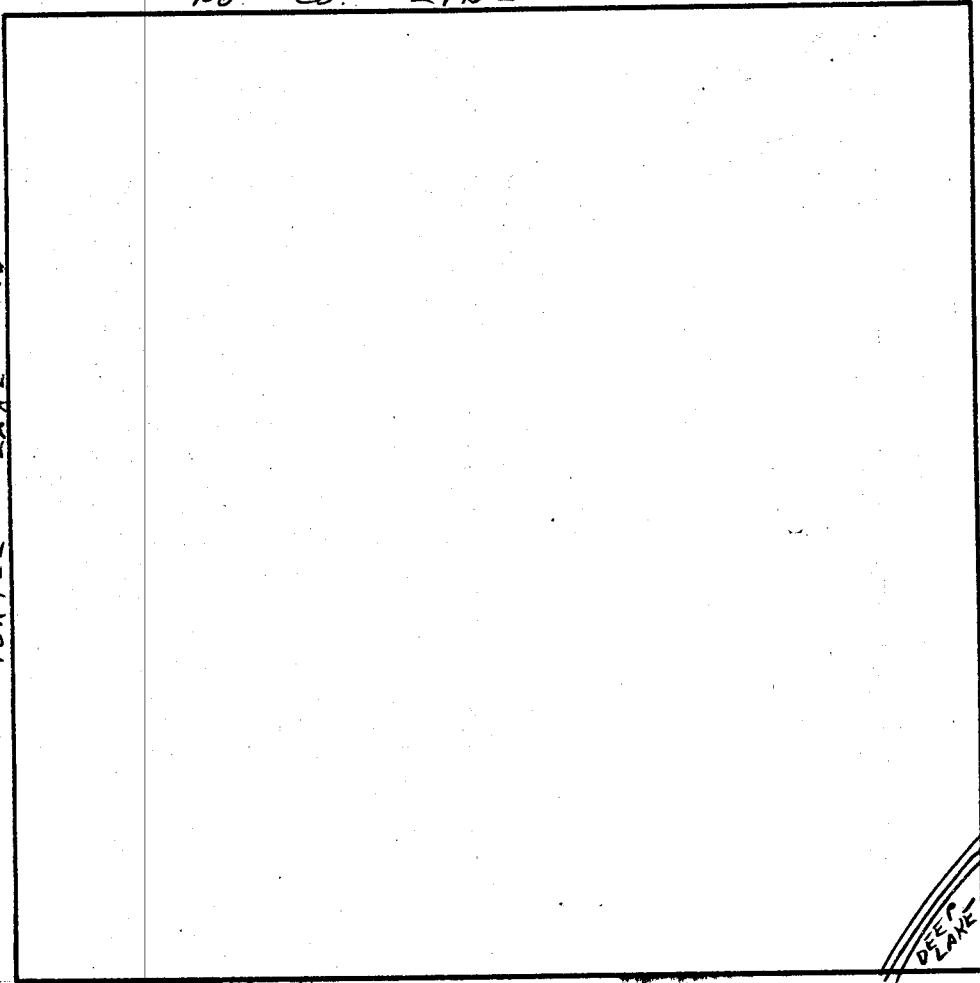

DEEP LAKE