


S.W. 1/4, SEC. 9, TWP. 30, RGE. 22

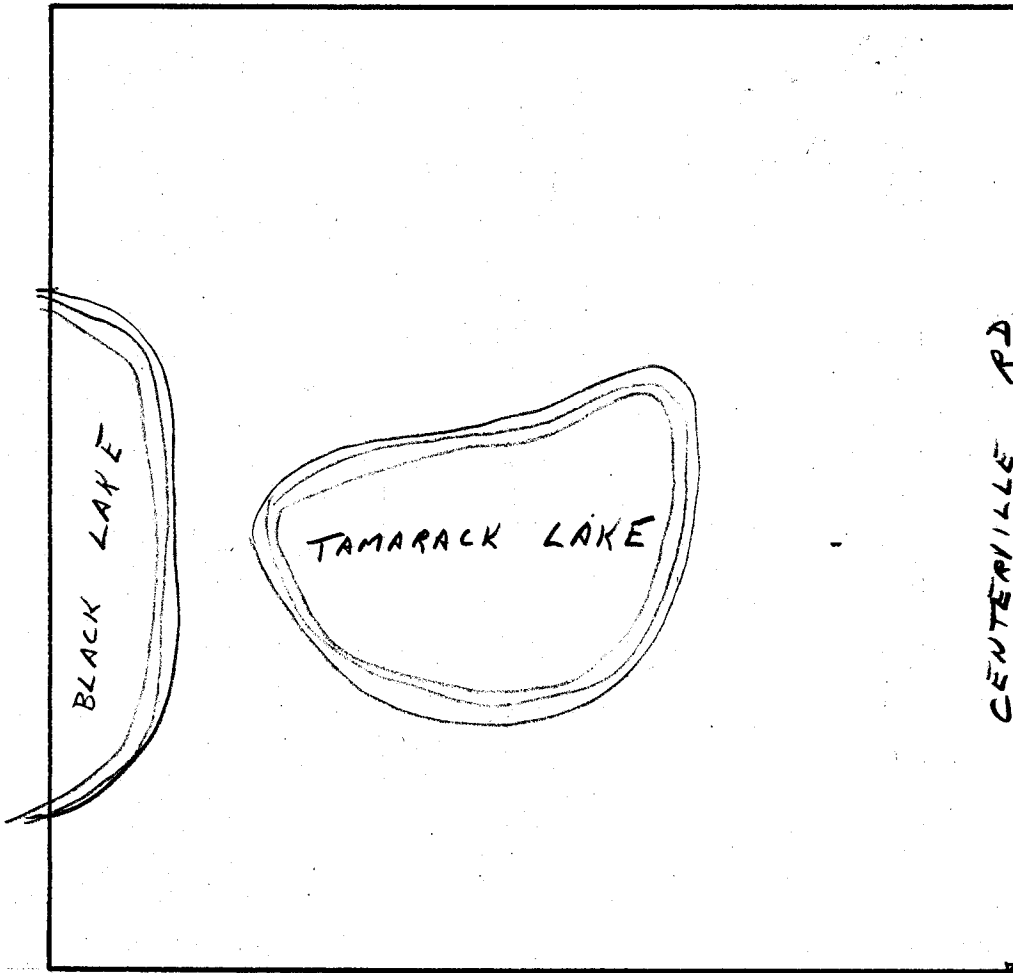

38.46-38.85-034
PP
HOLE
IN
CULVERT